


PROPRIETARY MATERIAL  
NOT TO BE RE-PRODUCED OR DISTRIBUTED  
WITHOUT THE PRIOR WRITTEN CONSENT OF  
TOROMONT ENERGY SYSTEMS INC.

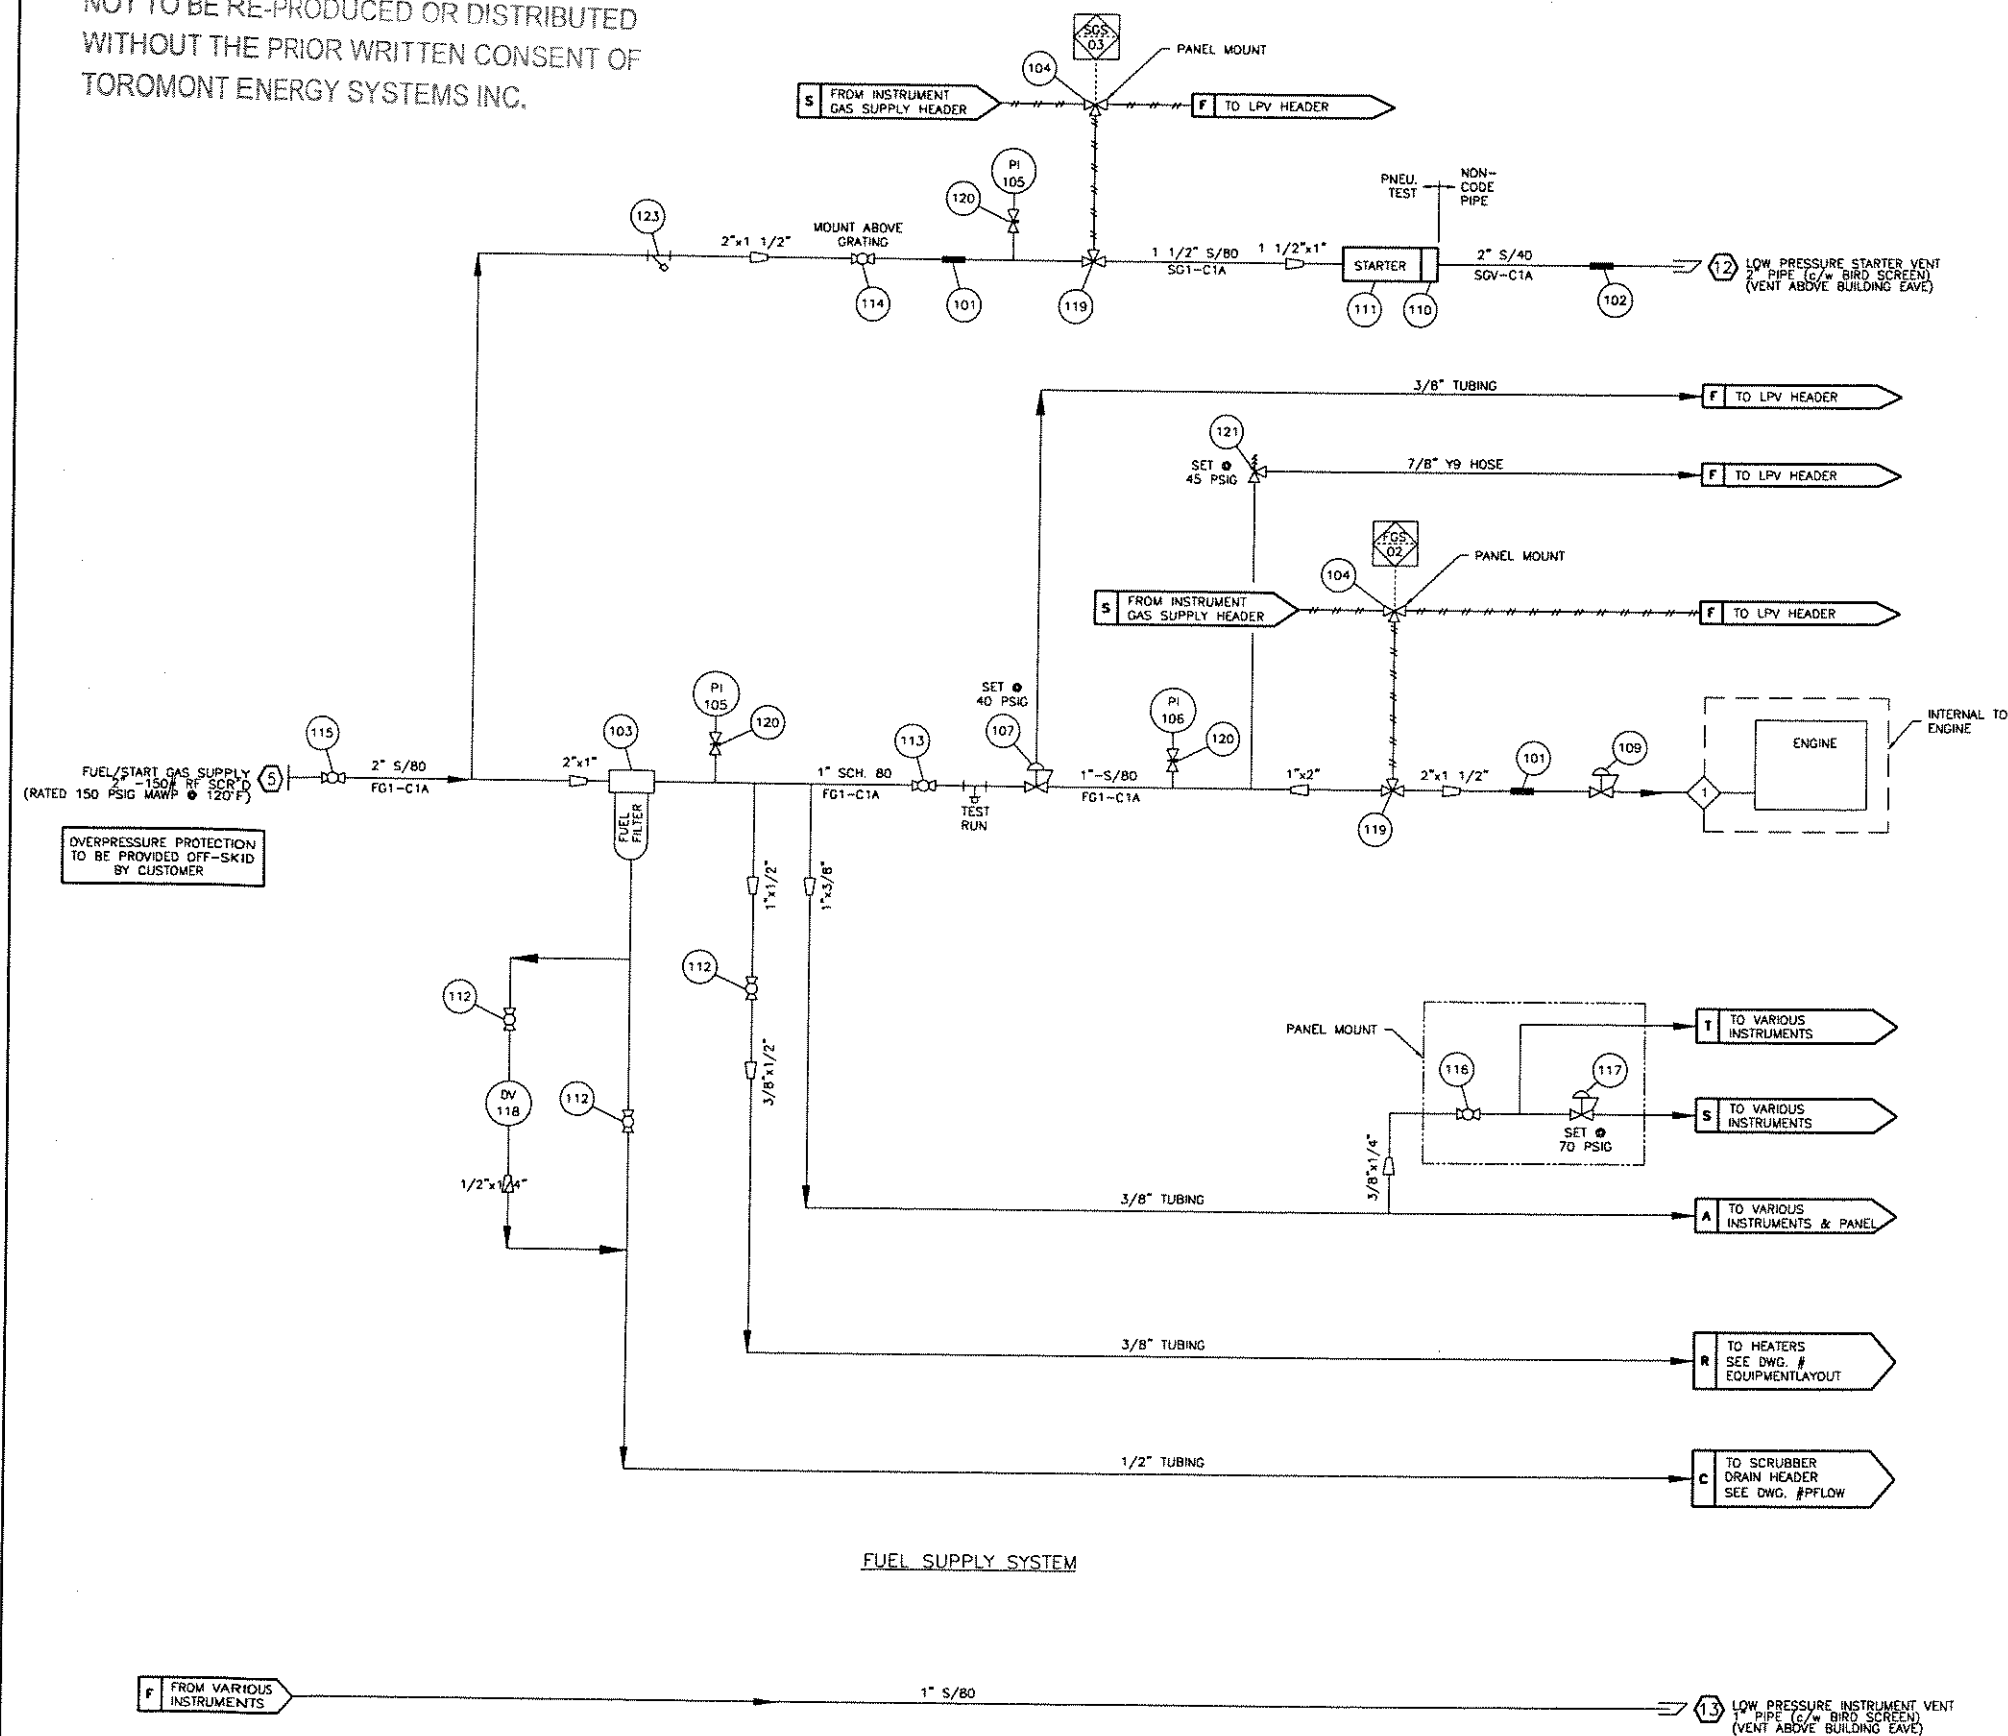

BILL OF MATERIALS			
No.	PART No.	DESCRIPTION	QUANTITY
101	BBA504	CONNECTOR, BRAIDED, HALESON, 1 1/2" FNPT HEX HEAD BOTH ENDS, 12" LG, T321 SS HOSE, T304 SS BRAID, S/40 C.S. NIPPLE, DUCTILE IRON HEX, 500 PSIG @ 400F	2
102	BBA506	CONNECTOR, BRAIDED, HALESON, 2" FNPT HEX HEAD BOTH ENDS, 12" LG, T321 SS HOSE, T304 SS BRAID, S/40 C.S. NIPPLE, DUCTILE IRON HEX, 450 PSIG @ 400F	1
103	NPN	FILTER, FUEL GAS, BALSTON #A962, 1" FNPT x 1" FNPT, 1" PORT, 15-250 PSI MAX, 0.130F, FILTER CARTRIDGE GRADE DX, ANODIZED ALUMINUM HEAD, STAINLESS STEEL INTERNAL, BUNA-N SEALS c/w P INDICATOR	1
104	12C277	VALVE, SOLENOID, ASCO, EF8320C202-24, 115 PSIG MAX, 24 VDC (w/kit)	2
105	10X113	GALUGE, PRESSURE, WIKA, 213.53.063, 0.25" MNPT BOTTOM MNT, 0-200 PSIG, MAX 140F, 2.5" FACE, LIQUID FILLED, DUAL SCALE, SS CASE, BRASS INTERNALS	2
106	BBA726	GALUGE, PRESSURE, WIKA, 213.53.063, 0.25" MNPT BOTTOM MNT, 0-60 PSIG, MAX 140F, 2.5" FACE, LIQUID FILLED, DUAL SCALE, SS CASE, BRASS INTERNALS	1
107	NPN	REGULATOR, PRESSURE, FISHER, 627-497, 1" FNPT, 15-40 PSIG, 300 PSIG INLET, 0.5" TRIM, GREEN SPRING, DUCTILE IRON	1
108	-	-	-
109	NPN	REGULATOR, PRESSURE, FISHER, Y692, 1.5" FNPT, 0.75" DRIFICE (c/w ENGINE)	1
110	NPN	STARTER FLANGE, TDI, MODEL T302739B, 2" NPT	1
111	NPN	STARTER, GAS, TDI, T306-60015-01R, 1" FNPT x 2" FNPT, 120-60 PSIG, ALUMINUM	1
112	M22CR-.5	VALVE, BALL, MERIDIAN, M22CR-.5, 0.5" FNPT, 2000 PSIG @ 150F, ASTM A216 WCB, NACE MR01-75, LOCKING HANDLES	3
113	M22CR-1.0	VALVE, BALL, MERIDIAN, M22CR-1.0, 1" FNPT, 2000 PSIG @ 150F, ASTM A216 WCB, NACE MR01-75, LOCKING HANDLES	1
114	M22CR-1.5	VALVE, BALL, MERIDIAN, M22CR-1.5, 1.5" FNPT, 2000 PSIG @ 150F, ASTM A216 WCB, NACE MR01-75, LOCKING HANDLES	1
115	M22CR-2.0	VALVE, BALL, MERIDIAN, M22CR-2.0, 2.0" FNPT, 2000 PSIG @ 150F, ASTM A216 WCB, NACE MR01-75, LOCKING HANDLES	1
116	M11S-.25	VALVE, BALL, MERIDIAN, M11S-.25, 0.25" FNPT, 1000 PSIG @ 150F, ASTM A351CF8M BODY & BALL, 316SS STEM	1
117	67CFR/0-125	REGULATOR, FISHER, 67CFR, 0-125 PSIG, SET @ 70 PSIG (w/kit)	1
118	NPN	VALVE, DRAIN, WATSON MCDANIEL, WLD 1811, 0.75" NPT INLET, 0.5" NPT OUTLET, 0.078" DRIFICE, 400 PSIG	1
119	11A708	VALVE, CONTROL, RELAY, TDI, RLVA 25683001201, 1.5" FNPT, 18-70 PSI SUPPLY, 450 PSI MAWP, MAX. 200F, ALUMINUM	2
120	B8A607	VALVE, NEEDLE, CENTURY, CM2-3-M22T-B-V, 0.25" MNPT x 0.25" FNPT, 6000 PSIG @ 100F, ASTM A108, CAST IRON	3
121	B8E254	VALVE, RELIEF, FISHER, 1805-13X1, 1" FNPT, 10-60 PSIG, MAX 150F, CADMIUM SPRING, ASTM A108, CAST IRON	1
122	-	-	-
123	B8E567	Y-STRAINER, SUREFLOW, 0200-YT6-032, 2" FNPT, 20 MESH, 1480 PSIG @ 100F, 304SS MESH, ASTM A216	1
124	-	-	-
125	-	-	-

TOROMONT ENERGY SYSTEMS  
JUN 08 2006  
AS BUILT  
PER \_\_\_\_\_

NOTES:  
1. FOR ALL OTHER NOTES & GENERAL INFORMATION SEE DWG. #PFLOW.  
2. -  
3. SIGNAL TUBING IS 1/4".

SERVICE:		TUBING	FITTINGS
SWEET:	PROCESS	304 (SS)	ZINC PLATED (S)
	UTILITY (CONTACTING PROCESS)	304 (SS)	ZINC PLATED (S)
	INSTRUMENT	304 (SS)	ZINC PLATED (S)
SOUR:	PROCESS	316 (SS)	316 (SS)
	UTILITY (CONTACTING PROCESS)	316 (SS)	316 (SS)
	INSTRUMENT	304 (SS)	ZINC PLATED (S)
	FRAME INTERNALS	316 (SS)	316 (SS)

2	AS BUILT	03/26/06	GG
1	UNIT SOLD TO PRAIRIE SCHOONER PETROLEUM LTD.	12-15-05	TN
No.	REVISION	DATE	BY
PROPRIETARY MATERIAL: NOT TO BE REPRODUCED OR DISTRIBUTED WITHOUT THE PRIOR WRITTEN CONSENT OF TOROMONT ENERGY SYSTEMS INC.			
TOROMONT ENERGY SYSTEMS		10121 - BARLOW TRAIL N.E. CALGARY ALBERTA CANADA	
TITLE:		CUSTOMER:	
FUEL & START GAS FLOW DIAGRAM WAUKESHA H24GL			
SCALE: NONE	DATE: 04/12/05	BY: GP	DATE RELEASED: 12/14/05
STEP # 510	UNIT # 31233		