


PROPRIETARY MATERIAL
NOT TO BE REPRODUCED OR DISTRIBUTED
WITHOUT THE PRIOR WRITTEN CONSENT OF
TOROMONT ENERGY SYSTEMS INC.

TOROMONT ENERGY SYSTEMS

JUN 08 2006
AS BUILT

PER _____

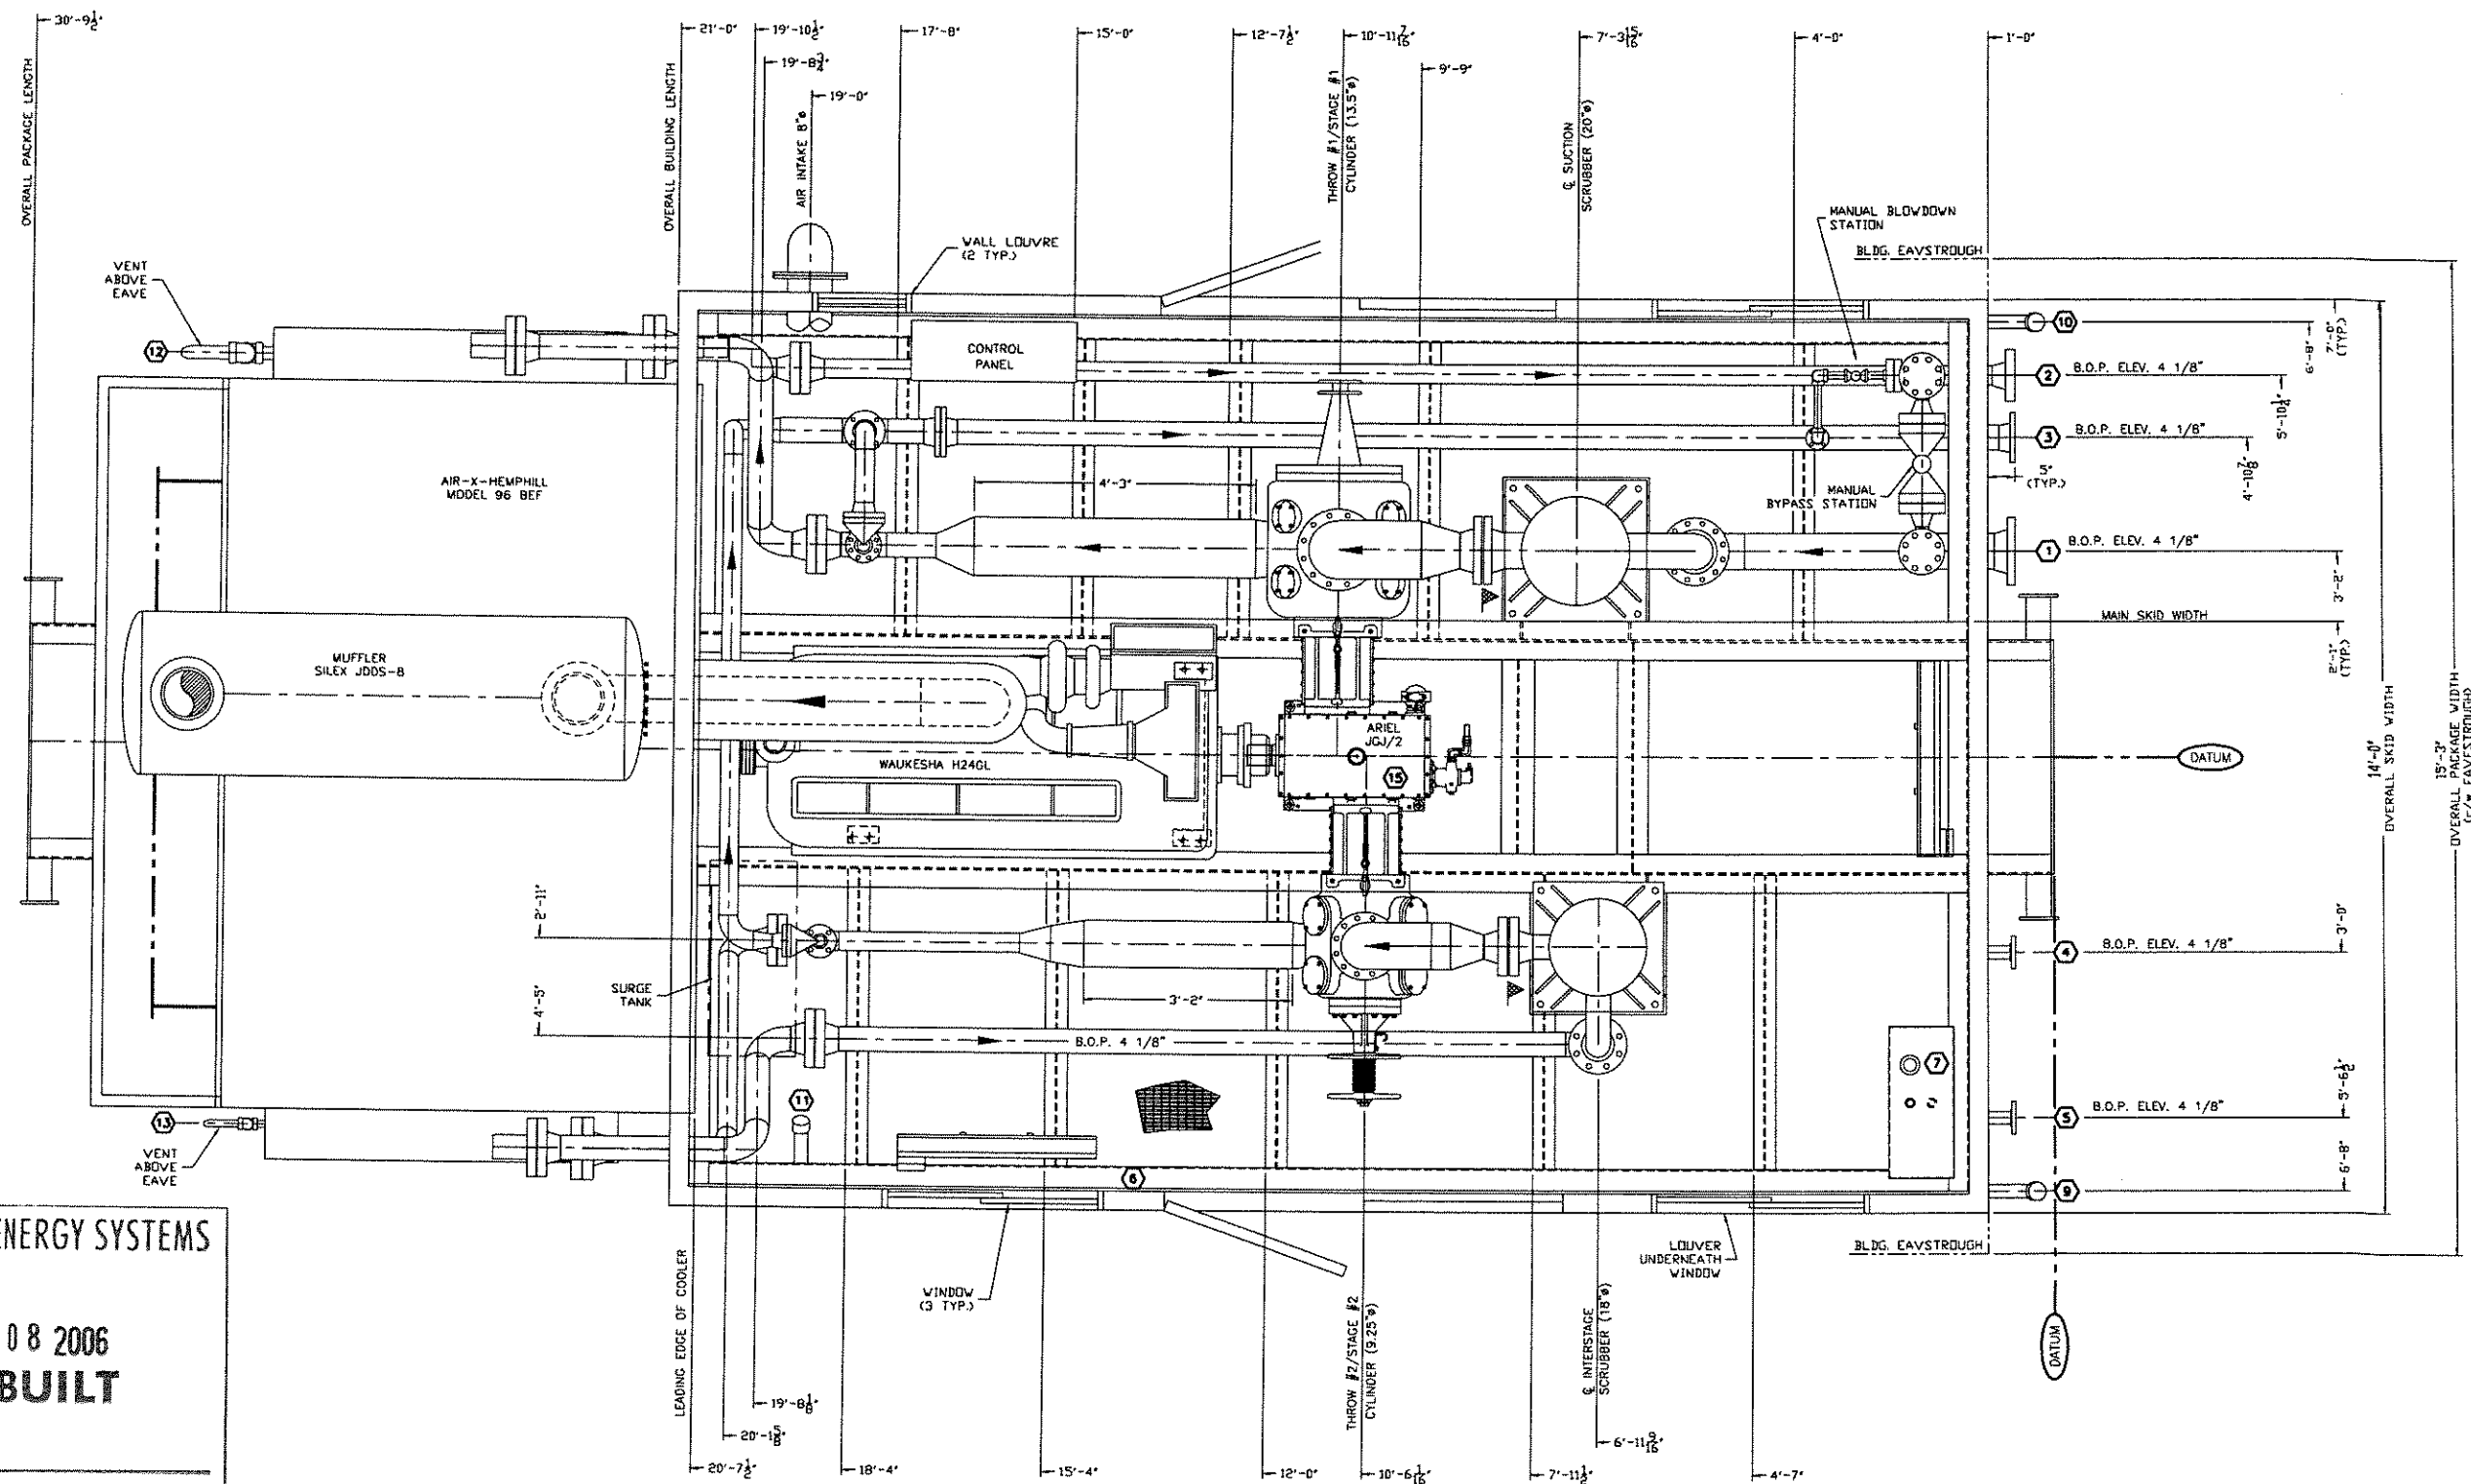


GENERAL SPECIFICATIONS

OVERALL PACKAGE LENGTH (FT)	30'-9 1/2"
OVERALL PACKAGE WIDTH (FT)	15'-3"
OVERALL PACKAGE HEIGHT (FT) (11' EAVE)	15'-3"
OVERALL PACKAGE WEIGHT (LBS)	57,800 est.
GLYCOL STORAGE CAPACITY (U.S. GAL.)	100
WASTE OIL STORAGE CAPACITY (U.S. GAL.)	100
SOUR WASTE OIL STORAGE CAPACITY (U.S. GAL.)	N/A
LUBE OIL DAY TANKS	<input checked="" type="checkbox"/> 56 U.S. GAL. <input type="checkbox"/> CRANE RAILS B3 U.S. GAL.
BRIDGE CRANE	<input type="checkbox"/> YES <input checked="" type="checkbox"/> NO <input type="checkbox"/> 2-TON <input type="checkbox"/> 3-TON <input type="checkbox"/> 5-TON
SEAL PAN	<input type="checkbox"/> YES <input checked="" type="checkbox"/> NO <input type="checkbox"/> FLAT <input type="checkbox"/> SLOPED (1" OVER 10' TO OUT SIDE)
LOADING METHOD	<input type="checkbox"/> JACK & ROLL <input checked="" type="checkbox"/> LIVE ROLL <input type="checkbox"/> CRANE
PROCESS GAS	<input checked="" type="checkbox"/> SWEET <input type="checkbox"/> SOUR <input type="checkbox"/> ACID GAS PERCENT SOUR <0.5% H ₂ S

NOTES:
1. ALL DIMENSIONS TAKEN FROM BOTTOM OF SKID.
2. ALL OTHER NOTES FOUND ON DWG. #PFLOW.

CUSTOMER CONNECTIONS

1 INITIAL SUCTION	6"-300# RFWN	9 GLYCOL TANK DRAIN	2"-PIPE MNPT
2 FINAL DISCHARGE	3"-900# RFWN	10 WASTE OIL TANK DRAIN	2"-PIPE MNPT
3 HIGH PRESSURE VENT HEADER	4"-150# RFWN	11 GLYCOL STANDPIPE	2"-PIPE MNPT
4 SCRUBBER DRAIN HEADER	2"-150# RF SCR'D	12 START GAS VENT HEADER	2"-PIPE C/W BIRDSCREEN
5 FUEL/START GAS INLET	2"-150# RF SCR'D	13 LOW PRESSURE INSTRUMENT VENT HEADER	1"-PIPE C/W BIRDSCREEN
6 GLYCOL TANK FILL	3/4" HDSE	14 -	-
7 CYLINDER/ENGINE/COMPRESSOR OIL FILL	2"-3000# (NPT)	15 LOCAL COMPRESSOR OIL FILL	1"-3000# (NPT)
8 -	-	16 -	-

2	AS BUILT	03/26/06	GG
1	UNIT SOLD TO PRAIRIE SCHOONER PETROLEUM LTD.	12-15-05	TN
0	ISSUED FOR CONSTRUCTION	04/12/05	GP
No.	REVISION	DATE	BY
PROPRIETARY MATERIAL: NOT TO BE REPRODUCED OR DISTRIBUTED WITHOUT THE PRIOR WRITTEN CONSENT OF TOROMONT ENERGY SYSTEMS INC.			
		10121 - BARLOW TRAIL N.E. CALGARY ALBERTA CANADA	
TITLE:		CUSTOMER:	
GENERAL ARRANGEMENT WAUKESHA H24GL / ARIEL JGJ/2 FRAME AIR-X-HEMPHILL 96 BEF			
SCALE: 3/4"=1'-0"	DATE: 09/03/04	BY: GP	DATE RELEASED: 12/29/06
W.D. # 31233	UNIT # 31233		