

NOZZLE SCHEDULE				
MARK	SERVICE	SIZE	RATING	TYPE
1	AIR INLET	8"	300#	RF
2	FINAL DISCHARGE	4"	600#	RF
3	HIGH PRESSURE VENT HEADER (AIR)	4"	150#	RF
4	SCRUBBER DRAIN HEADER	2"	150#	RF
5	FUEL GAS INLET	1 1/2"	150#	RF
6	GLYCOL STAND PIPE	2"	3000#	MNPT
7	RECIP BYPASS OUTLET	4"	600#	RF
8	GLYCOL FILL	1"	3000#	FNPT
9	WASTE OIL DRAIN	2"	3000#	MNPT
10	WASTE GLYCOL DRAIN	2"	3000#	MNPT
11	ENGINE/COMP LUBE OIL FILL	3/4"	-	HOSE
12	STARTER VENT	2"	-	PIPE
13	INSTRUMENT AIR SUPPLY	1"	3000#	FNPT
14	HIGH PRESSURE VENT HEADER (GAS)	2"	-	-
15	LP INSTRUMENT VENT HEADER	1"	-	PIPE
16	COMPRESSOR OIL FILL	2"	-	MNPT
17	START GAS INLET	1 1/2"	150#	RF
18	EXHAUST	8"	12GA	TUBE

GENERAL SPECIFICATIONS	
OVERALL PACKAGE LENGTH	31'-9 1/8"
OVERALL PACKAGE WIDTH	16'-9"
OVERALL PACKAGE HEIGHT (w/STACK)	24'-9"
OVERALL OPERATING PACKAGE WEIGHT (LBS)	75500
MAIN SKID SHIPPING WEIGHT (LBS)	74300
BRIDGE CRANE RATING	3 TON
SEAL PAN	<input checked="" type="checkbox"/> FLAT <input type="checkbox"/> NONE <input type="checkbox"/> SLOPED
LOADING METHOD	<input type="checkbox"/> LIVE ROLL <input type="checkbox"/> CRANE <input checked="" type="checkbox"/> JACK & ROLL
NOTES:	
1. ALL (2) DIMENSIONS TAKEN FROM TOP OF SKID.	
2. ALL OTHER NOTES FOUND ON DWG. #LEGEND.	
3. ALL SKID EDGE CONNECTIONS ±1/4" TOLERANCE.	
4. ⦿ ALL TAIL DIMENSIONS FROM REFERENCE POINT.	
5. SKID DEPTH:	
6. CENTER OF GRAVITY:	
"X" FROM REF. POINT: 164.287	
"Y" FROM REF. POINT: 0.839	
"Z" FROM REF. POINT: 30.798	

DESTROY PREVIOUS COPIES

FINAL AS BUILT

NAME *B. McLean* DATE *12/14/10*

3	AS BUILT	12/14/10	BM	K.G.
2	REMOVE HOT BYPASS SPOOLING - IFC	09/15/10	BM	K.G.
1	ISSUED FOR CONSTRUCTION	08/04/10	TT	K.G.
REV	DESCRIPTION	DATE	BY	APR

DATE	06/07/10	SCALE	3/4"=1'-0"
DRAWN BY	B. McLean	CHECKED BY	K. Green
CUST PO	N/A	APPROVED BY	B. Campbell
STEP CODE	198 298 490 511 591		

FOR
HUSKY OIL OPERATIONS LTD.
WAUKESHA F18GL
ARIEL JGJ/2-1/2 STD


ENERFLEX
10121 - BARLOW TRAIL N.E.
CALGARY ALBERTA CANADA

PERMIT TO PRACTISE	APEGGA PERMIT: No. P8651
TITLE	PLAN VIEW
DWG NO	31834-201
SHT	1
REV	3

C:\Users\jmclean\TES\updates\local\temp\AsP\As-Built_1860\31834-MODEL-AS-BUILT.dwg

PLOT DATE January 07, 2011

NOTE:
ALL TAIL DIMENSIONS ARE
TAKEN FROM REFERENCE
POINT  AT TOP OF SKID

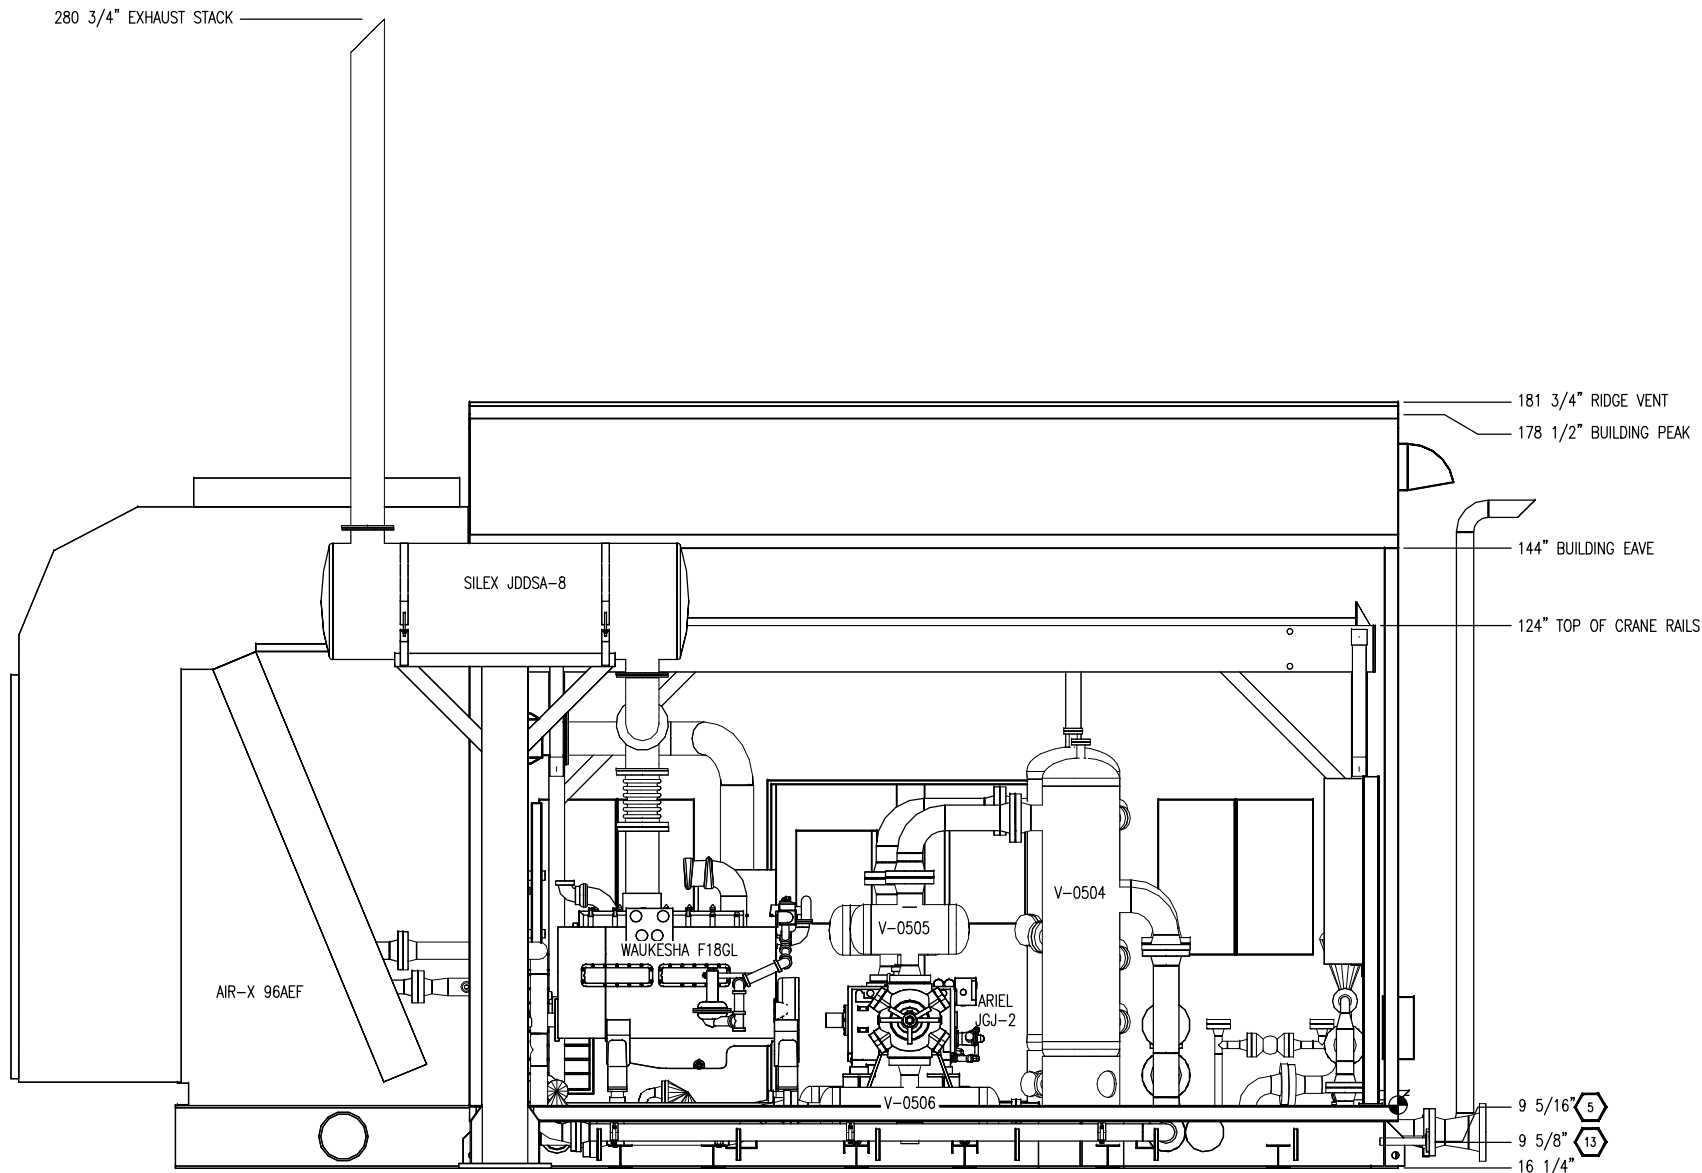

ELEVATION VIEW A-A

DESTROY PREVIOUS COPIES

**FINAL
AS BUILT**
NAME B. McLean DATE 12/14/10


										DATE 06/07/10		SCALE 1/2"=1'-0"		FOR HUSKY OIL OPERATIONS LTD. WAUKESHA F18GL ARIEL JG1/2-1/2 STD		ENERFLEX 10121 - BARLOW TRAIL N.E. CALGARY ALBERTA CANADA		PERMIT TO PRACTISE APEGGA PERMIT: No. P8651		TITLE <u>ELEVATION 'A-A'</u>	
3	AS BUILT				12/14/10	BM	K.G.	DRAWN BY <i>B. McLean</i>		CHECKED BY <i>K. Green</i>		APPROVED BY <i>B. Campbell</i>		CUST PO N/A							
2	REMOVE HOT BYPASS SPOOLING - IFC				09/15/10	BM	K.G.														
1	ISSUED FOR CONSTRUCTION				08/04/10	TT	KG														
REV	DESCRIPTION				DATE	BY	APR	STEP CODE		198 298 490 511 591				DWG NO 31834-201		SHT 2		REV 3			

THE INFORMATION CONTAINED HEREIN IS THE CONFIDENTIAL PROPERTY OF TORMONT ENERGY SYSTEMS AND IS NOT FOR PUBLICATION, AND NO PART THEREOF SHALL BE COPIED OR COMMUNICATED TO A THIRD PARTY WITHOUT AUTHORIZATION FROM TORMONT ENERGY SYSTEMS.

C:\Users\jmclean\TES\updates\local\temp\AsBuilt\31834-MODEL-AS-BUILT.dwg

PLOT DATE January 07, 2011

NOTE:
ALL TAIL DIMENSIONS ARE
TAKEN FROM REFERENCE
POINT  AT TOP OF SKID

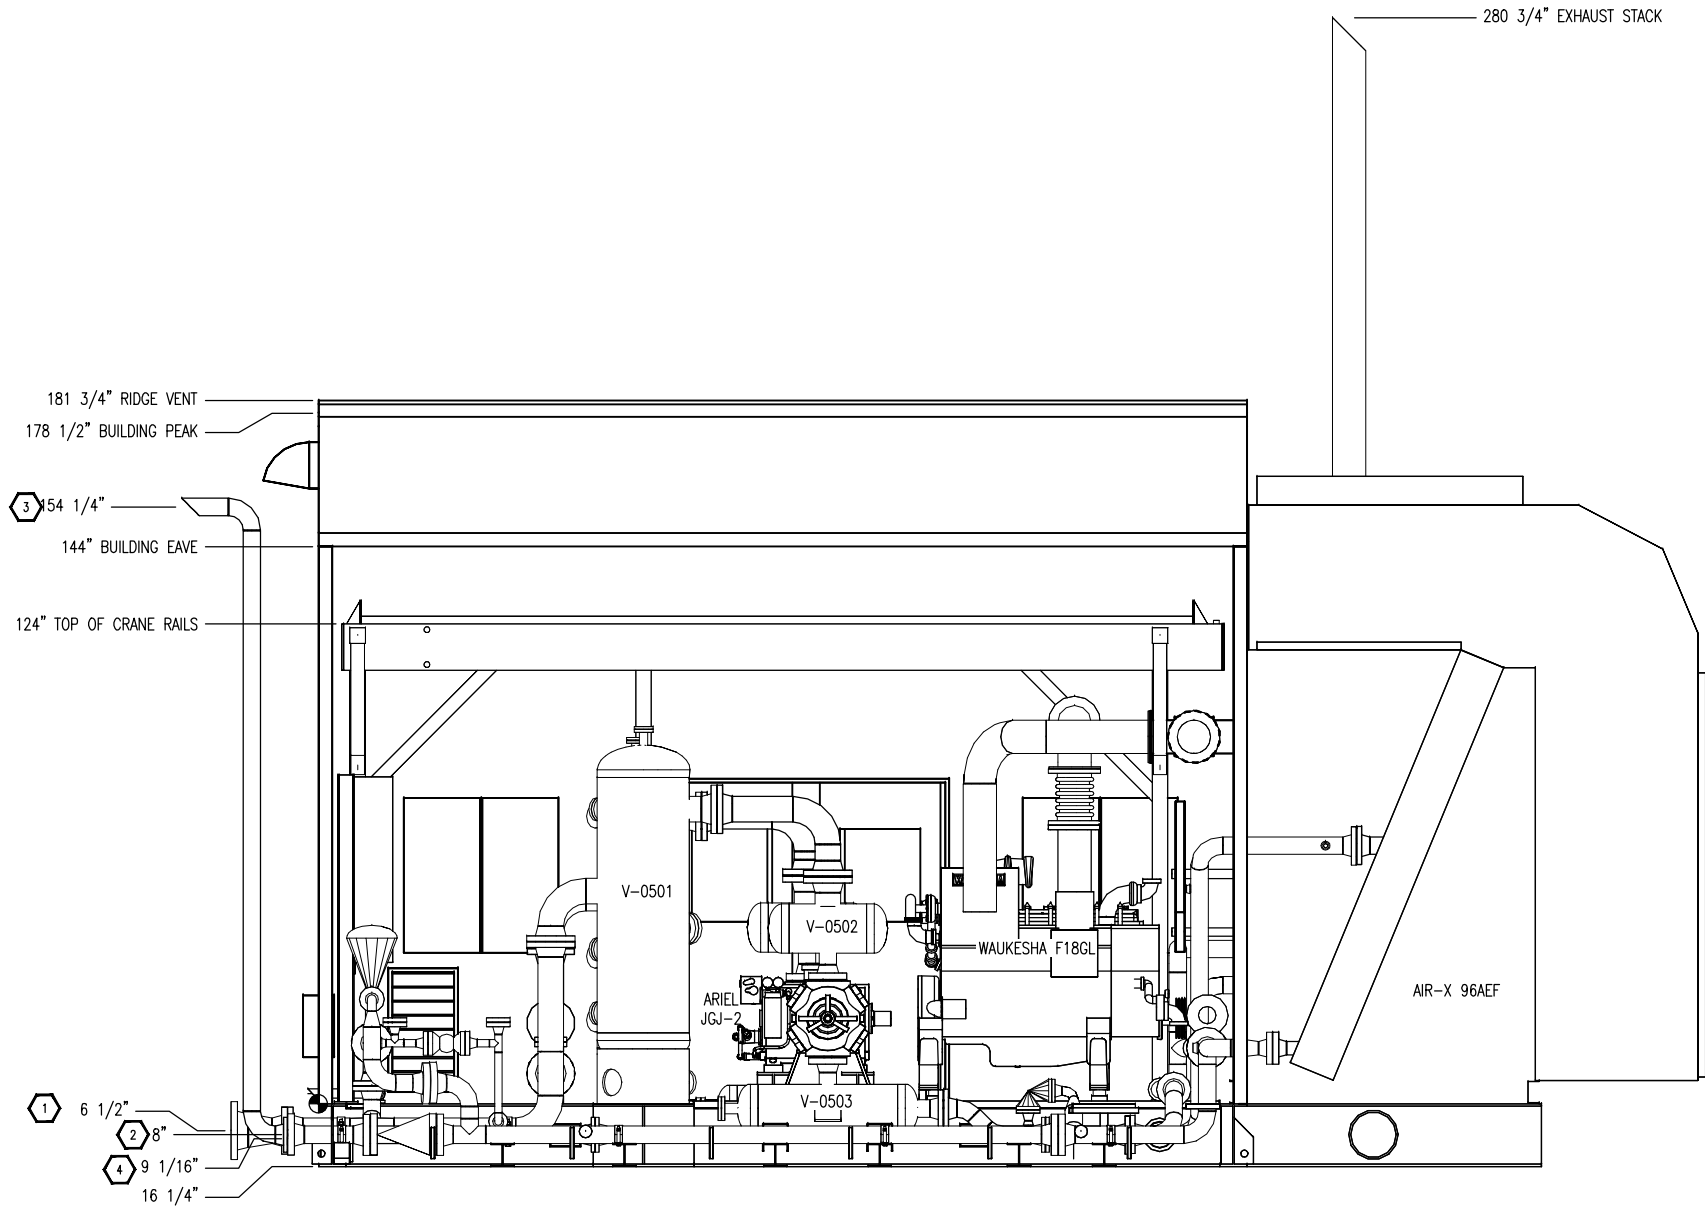

ELEVATION VIEW B-B

DESTROY PREVIOUS COPIES

**FINAL
AS BUILT**
NAME B. McLean DATE 12/14/10

PERMIT TO
PRACTISE APEGGA PERMIT: No. P8651

TITLE
ELEVATION 'B-B'

DATE 06/07/10 SCALE 1/2"=1'-0"
DRAWN BY B. McLean CHECKED BY K. Green APPROVED BY B. Campbell
CUST PO N/A
STEP CODE 198 298 490 511 591

FOR
HUSKY OIL OPERATIONS LTD.
WAUKESHA F18GL
ARIEL JGJ/2-1/2 STD

ENERFLEX
10121 - BARLOW TRAIL N.E.
CALGARY ALBERTA CANADA



DWG
NO 31834-201

SHT 3

REV 3

THE INFORMATION CONTAINED HEREIN IS THE CONFIDENTIAL PROPERTY OF TORMONT ENERGY SYSTEMS AND IS NOT FOR PUBLICATION, AND NO PART THEREOF SHALL BE COPIED OR COMMUNICATED TO A THIRD PARTY WITHOUT AUTHORIZATION FROM TORMONT ENERGY SYSTEMS.

PLOT DATE January 07, 2011
C:\Users\jmclean\TES\updates\local\temp\AsP\AsBuilt_1860\31834-MODEL-AS-BUILT.dwg

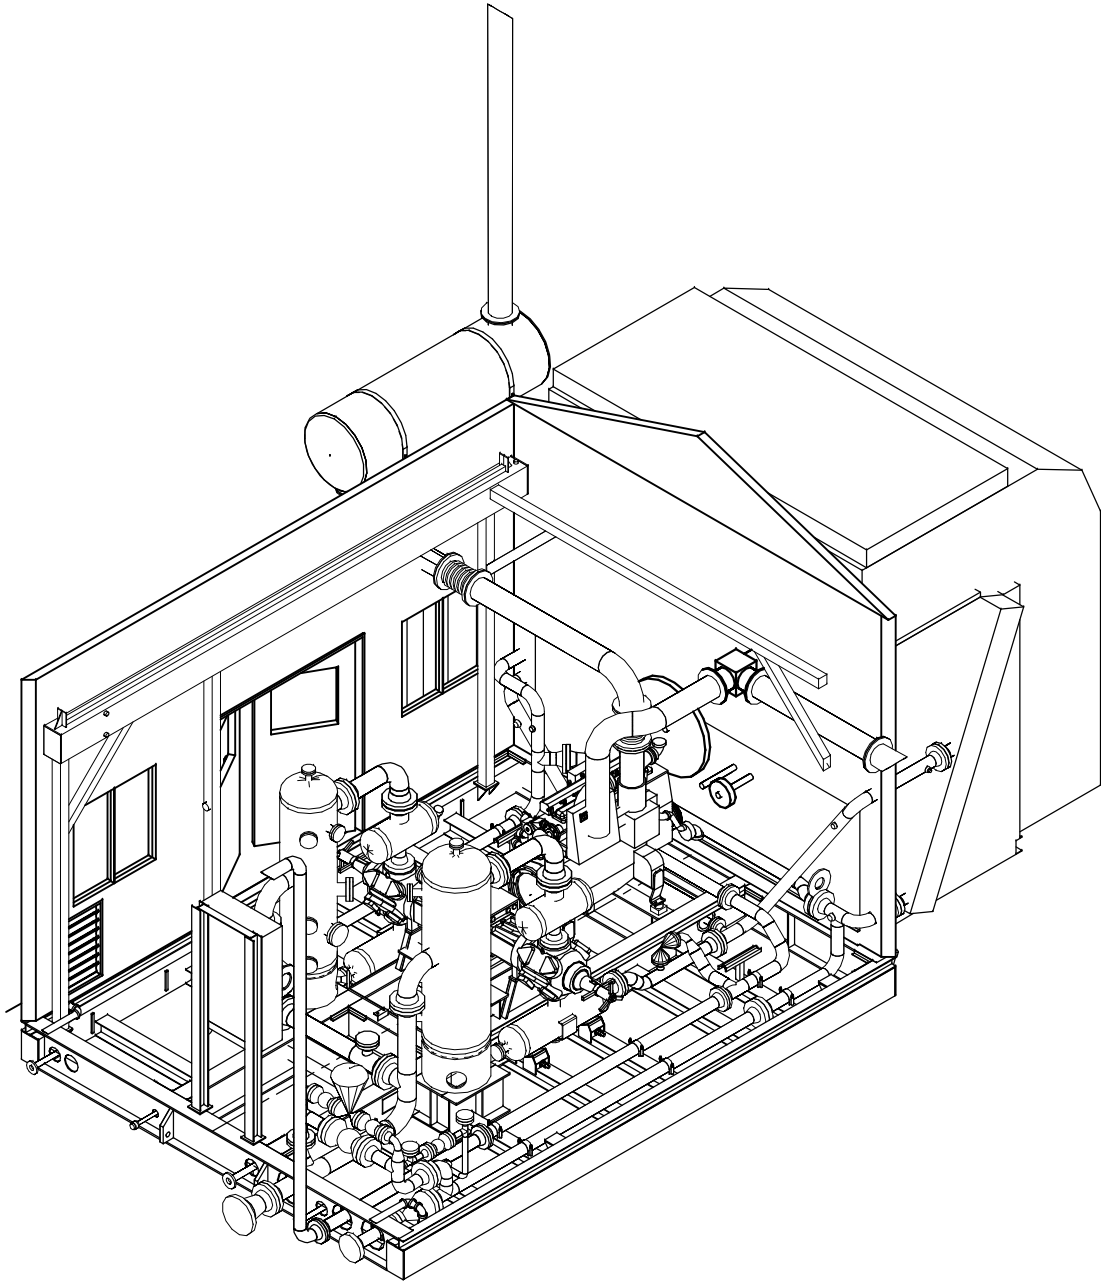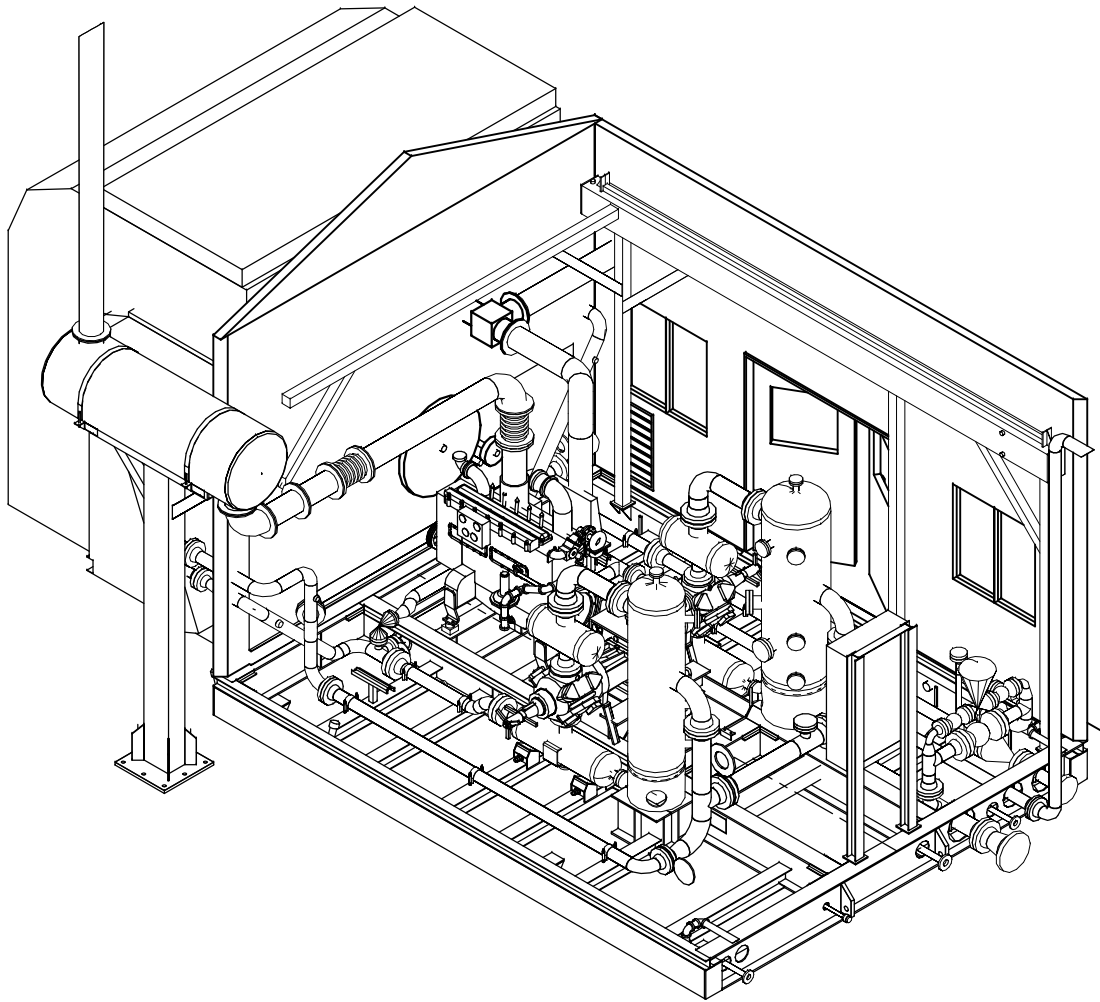

3D VIEW

DESTROY PREVIOUS COPIES

**FINAL
AS BUILT**
NAME B. McLean DATE 12/14/10

3	AS BUILT	12/14/10	BM	K.G.
2	REMOVE HOT BYPASS SPOOLING - IFC	09/15/10	BM	K.G.
1	ISSUED FOR CONSTRUCTION	08/04/10	TT	KG
REV	DESCRIPTION	DATE	BY	APR

DATE	06/07/10	SCALE	3/8"=1'-0"
DRAWN BY	B. McLean	CHECKED BY	K. Green
APPROVED BY	B. Campbell	CUST PO	N/A
STEP CODE	198	298	490 511 591

FOR
HUSKY OIL OPERATIONS LTD.
WAUKESHA F18GL
ARIEL JG1/2-1/2 STD


ENERFLEX
10121 - BARLOW TRAIL N.E.
CALGARY ALBERTA CANADA

PERMIT TO PRACTISE	APEGGA PERMIT: No. P8651
TITLE	3D VIEW
DWG NO	31834-201
SHT	4
REV	3

THE INFORMATION CONTAINED HEREIN IS THE CONFIDENTIAL PROPERTY OF TORMONT ENERGY SYSTEMS AND IS NOT FOR PUBLICATION, AND NO PART THEREOF SHALL BE COPIED OR COMMUNICATED TO A THIRD PARTY WITHOUT AUTHORIZATION FROM TORMONT ENERGY SYSTEMS.

C:\Users\jmclean\TES\workspace\local\temp\AsP\AsBuilt_1860\31834-MODEL-AS-BUILT.dwg

PLOT DATE January 07, 2011

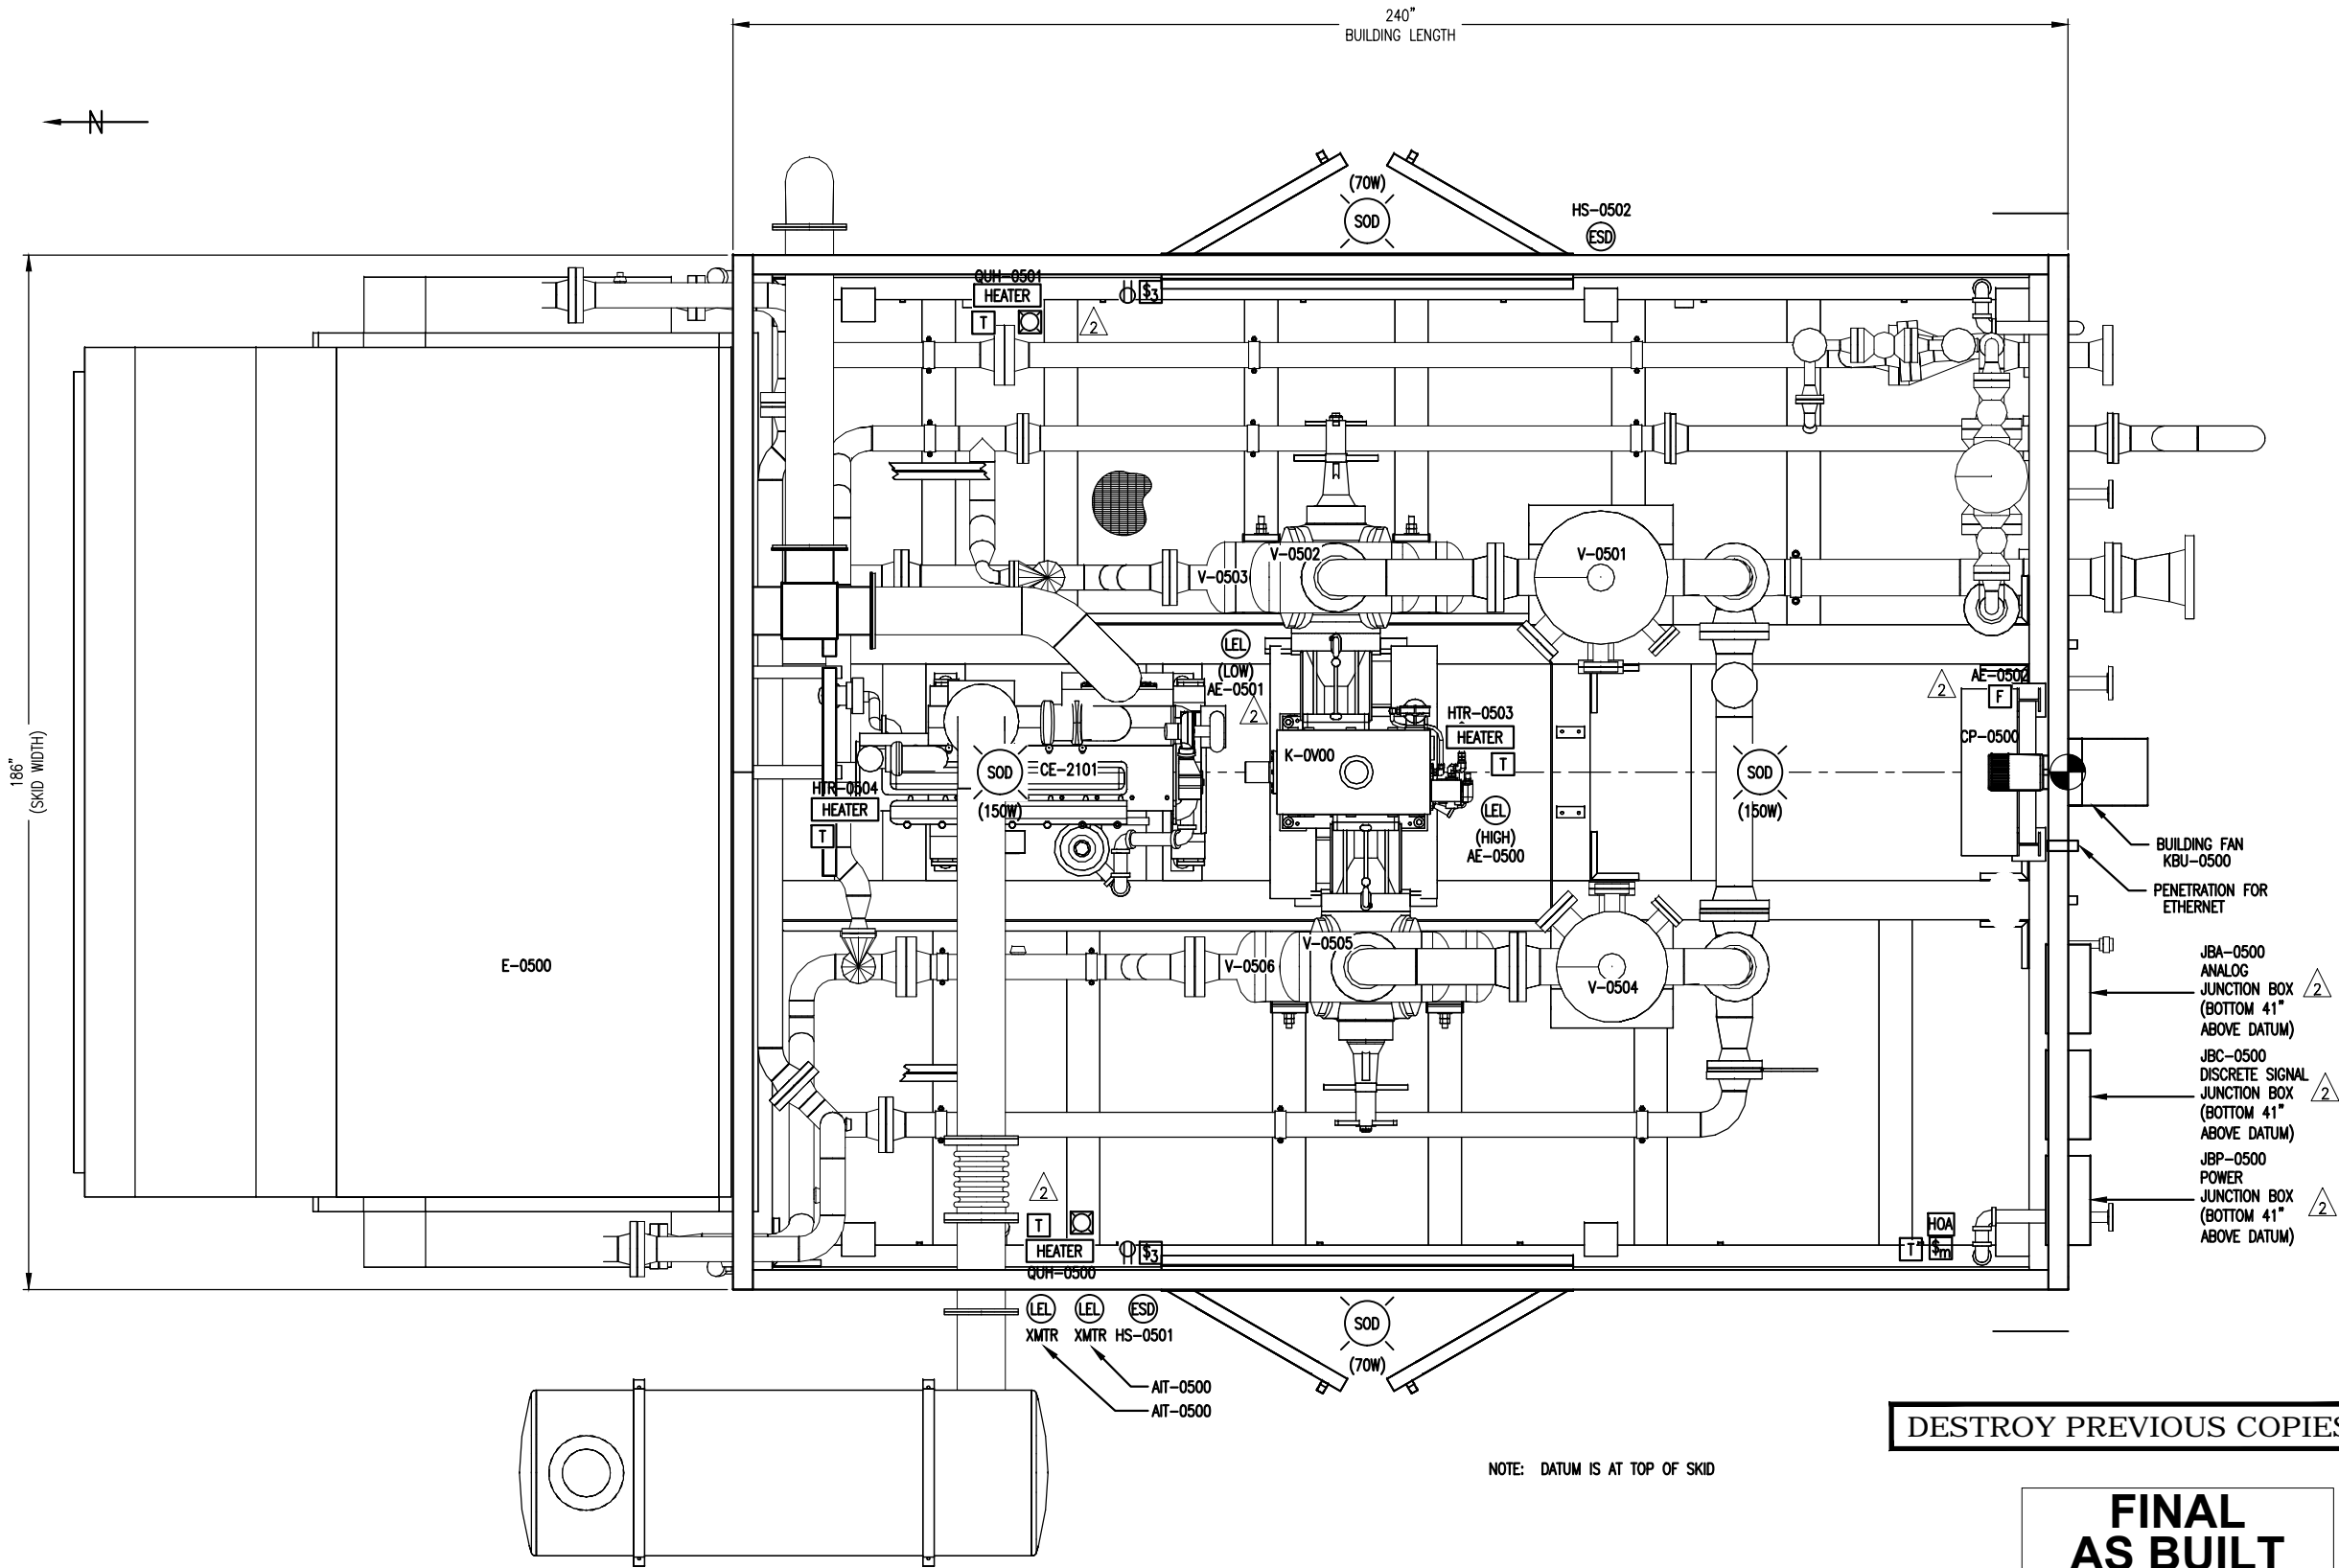

PLAN VIEW

4	AS BUILT	12/14/10	CE	K.G.
3	REVISE AS PER CUSTOMER MARK UP	10/29/10	CE	K.G.
2	REVISE AS PER CUSTOMER MARK UP	10/27/10	BM	K.G.
1	ISSUED FOR CONSTRUCTION	08/04/10	BM	K.G.
REV	DESCRIPTION	DATE	BY	APR

DATE	06/17/10	SCALE	3/4"=1'-0"
DRAWN BY	B. McLean	CHECKED BY	K. Green
APPROVED BY	B. Campbell	CUST PO	N/A
STEP CODE	198	298	490 511 591

HUSKY OIL OPERATIONS LTD.
WAUKESHA F18GL
ARIEL JG1/2-1/2 STD

ENERFLEX
10121 - BARLOW TRAIL N.E.
CALGARY ALBERTA CANADA

DWG NO 31834-201

SHT 5

REV 4

PERMIT TO PRACTISE APEGGA PERMIT: No. P8651

TITLE
ELECTRICAL LAYOUT

THE INFORMATION CONTAINED HEREIN IS THE CONFIDENTIAL PROPERTY OF TORMONT ENERGY SYSTEMS AND IS NOT FOR PUBLICATION, AND NO PART THEREOF SHALL BE COPIED OR COMMUNICATED TO A THIRD PARTY WITHOUT AUTHORIZATION FROM TORMONT ENERGY SYSTEMS.

ELECTRICAL LEGEND	
SYMBOL	DESCRIPTION
	LIGHT
	INCANDESCENT LIGHT
	H.P. SODIUM LIGHT
	BATTERY POWERED EMERGENCY LIGHT
	RECEPTACLE
	THERMOSTAT
	FIRE EYE
	FIRE PULL STATION
	COMBUSTIBLE LEL GAS ALARM BEACON
	TOXIC GAS H2S ALARM BEACON
	FIRE ALARM STROBE
	ALARM HORN
	CO SENSOR
	COMBUSTIBLE DETECTION
	H2S SENSOR
	HEATER
	TIMER SWITCH
	EMERGENCY SHUT DOWN BUTTON
	-
	-
FLOW DIAGRAM	LINE NUMBER	SERVICE	SIZE (INCH)	FROM	TO	TESI PIPE SPEC	WALL THICKNESS (SCHEDULE)	DESIGN PRESSURE (KPAG)	DESIGN TEMP. (Deg. C)	CORROSION ALLOWANCE (mm)	TEST PRESSURE (KPAG)	X-RAY	NOTES	PIPE MATERIAL	FLANGE MATERIAL	CODE	PWHT
31834-111-SHT. 1	6"-HG-INLET-1-L31R	NORMAL FLUID (AIR)	4 / 6 / 8	AIR INLET 4"-HG-BYPASS-1-C31R	V-0501 INLET 6"-HG-INLET-1-C31R	L31R	40 / 40 / 40	4516	-45/149	1.5875	6774	10%	1, 3	SA-333 Grade 6	SA-350-LF2	B31.3	NO
31834-111-SHT. 1	6"-HG-INLET-1-C31R	NORMAL FLUID (AIR)	3 / 6	6"-HG-INLET-1-L31R	4"-HG-IC1-1-C31R	C31R	40 / 40	4516	-29/149	1.5875	6774	10%	1, 3	SA-106-B	SA-105	B31.3	NO
31834-111-SHT. 1	6"-HG-V-0501-1-C31R	NORMAL FLUID (AIR)	6	V-0501 OUTLET	V-0502 INLET	C31R	40	4516	-29/149	1.5875	6774	10%	1, 3	SA-106-B	SA-105	B31.3	NO
31834-111-SHT. 1	4"-HG-CYL-0501-1-C31R	NORMAL FLUID (AIR)	1.5 / 4	V-0503 OUTLET	4"-HG-CYL-0501-2-L31R	C31R	XS / 40	4447	-29/177	1.5875	6671	10%	1, 3	SA-106-B	SA-105	B31.3	NO
31834-111-SHT. 1	4"-HG-CYL-0501-2-L31R	NORMAL FLUID (AIR)	1.5 / 2 / 4	4"-HG-CYL-0501-1-C31R	2"-HG-CYL-0501-1-C31R IC1 SECTION INLET	L31R	XS / XS / 40	4447	-45/177	1.5875	6671	10%	1, 3	SA-333 Grade 6	SA-350-LF2	B31.3	NO
31834-111-SHT. 1	2"-HG-CYL-0501-1-C31R	NORMAL FLUID (AIR)	2	4"-HG-CYL-0501-2-L31R	4"-HG-CYL-0502-2-L61R	C31R	XS	4447	-29/177	1.5875	6671	10%	1, 3	SA-106-B	SA-105	B31.3	NO
31834-111-SHT. 1	4"-HG-IC1-1-L31R	NORMAL FLUID (AIR)	4	IC1 SECTION OUTLET	4"-HG-IC1-1-C31R 4"-HG-IC1-2-C31R	L31R	40	4516	-45/149	1.5875	6774	10%	1, 3	SA-333 Grade 6	SA-350-LF2	B31.3	NO
31834-111-SHT. 1	4"-HG-IC1-1-C31R	NORMAL FLUID (AIR)	4 / 6	4"-HG-IC1-1-L31R	6"-HG-INLET-1-C31R	C31R	40 / 40	4516	-29/149	1.5875	6774	10%	1, 3	SA-106-B	SA-105	B31.3	NO
31834-111-SHT. 2	4"-HG-IC1-2-C31R	NORMAL FLUID (AIR)	4	4"-HG-IC1-1-L31R	4"-HG-AC-1-L61R	C31R	40	4516	-29/149	1.5875	6774	10%	1, 3	SA-106-B	SA-105	B31.3	NO
31834-111-SHT. 2	6"-HG-V-0504-1-C31R	NORMAL FLUID (AIR)	6	V-0504 OUTLET	V-0505 INLET	C31R	40	4516	-29/149	1.5875	6774	10%	1, 3	SA-106-B	SA-105	B31.3	NO
31834-111-SHT. 2	4"-HG-CYL-0502-1-C61R	NORMAL FLUID (AIR)	4	V-0506 OUTLET	4"-HG-CYL-0502-2-L61R	C61R	XS	8880	-29/177	1.5875	13320	10%	1, 3	SA-106-B	SA-105	B31.3	NO
31834-111-SHT. 2	4"-HG-CYL-0502-2-L61R	NORMAL FLUID (AIR)	1.5 / 2 / 3 / 4	4"-HG-CYL-0502-1-C61R 2"-HG-CYL-0501-1-C31R	4"-HG-PSV-1-C11R (PSV-0502 INLET) AC SECTION INLET	L61R	XS / XS / XS	8880	-45/177	1.5875	13320	10%	1, 3	SA-333 Grade 6	SA-350-LF2	B31.3	NO
31834-111-SHT. 2	4"-HG-AC-1-L61R	NORMAL FLUID (AIR)	3 / 4	AC SECTION OUTLET 4"-HG-IC1-2-C31R	4"-HG-AC-1-C61R	L61R	XS / XS	8880	-45/177	1.5875	13320	10%	1, 3	SA-333 Grade 6	SA-350-LF2	B31.3	NO
31834-111-SHT. 2	4"-HG-AC-1-C61R	NORMAL FLUID (AIR)	4	4"-HG-AC-1-L61R	4"-HG-AC-2-L61R 4"-HG-BYPASS-1-C61R	C61R	XS	8880	-29/177	1.5875	13320	10%	1, 3	SA-106-B	SA-105	B31.3	NO
31834-111-SHT. 2	4"-HG-AC-2-L61R	NORMAL FLUID (AIR)	4	4"-HG-AC-1-C61R	FINAL DISCHARGE	L61R	XS	8880	-45/177	1.5875	13320	10%	1, 3	SA-333 Grade 6	SA-350-LF2	B31.3	NO
31834-111-SHT. 2	4"-HG-BYPASS-1-C61R	NORMAL FLUID (AIR)	1.5 / 2 / 4	4"-HG-AC-1-C61R	4"-HG-BYPASS-1-C31R 1 1/2"-HG-BLOWDOWN-1-C11R	C61R	XS / XS / XS	8880	-29/177	1.5875	13320	10%	1, 3	SA-106-B	SA-105	B31.3	NO
31834-111-SHT. 2	4"-HG-BYPASS-1-C31R	NORMAL FLUID (AIR)	2 / 4	4"-HG-BYPASS-1-C61R	6"-HG-INLET-1-L31R	C31R	XS / 40	4516	-29/149	1.5875	6774	10%	1, 3	SA-106-B	SA-105	B31.3	NO
31834-111-SHT. 2	1 1/2"-HG-BLOWDOWN-1-C11R	NORMAL FLUID (AIR)	1.5	4"-HG-BYPASS-1-C61R	4"-HG-PSV-2-L11R	C11R	XS	1586	-29/149	1.5875	2379	10%	1, 3	SA-106-B	SA-105	B31.3	NO
31834-111-SHT. 2	4"-HG-PSV-1-C11R	NORMAL FLUID (AIR)	2 / 4	4"-HG-CYL-0501-1-C31R (PSV-0501 OUTLET) 4"-HG-CYL-0502-2-L61R (PSV-0502 OUTLET)	4"-HG-PSV-2-C11R	C11R	XS / 40	1586	-29/149	1.5875	2379	10%	1, 3	SA-106-B	SA-105	B31.3	NO
31834-111-SHT. 2	4"-HG-PSV-2-C11R	NORMAL FLUID (AIR)	4	4"-HG-PSV-1-C11R	4"-HG-PSV-2-L11R	C11R	40	1586	-29/149	1.5875	2379	10%	1, 3	SA-106-B	SA-105	B31.3	NO
31834-111-SHT. 2	4"-HG-PSV-2-L11R	NORMAL FLUID (AIR)	1.5 / 4	4"-HG-PSV-2-C11R 1 1/2"-HG-BLOWDOWN-1-C11R	4"-HG-PSV-3-L11R	L11R	XS / 40	1586	-45/149	1.5875	2379	10%	1, 3	SA-333 Grade 6	SA-350-LF2	B31.3	NO
31834-111-SHT. 2	4"-HG-PSV-3-L11R	NORMAL FLUID (AIR)	4	4"-HG-PSV-2-L11R	HIGH PRESSURE VENT HEADER	L11R	40	NA	NA	1.5875	NA	10%	1, 3	SA-333 Grade 6	SA-350-LF2	B31.3	NO

NOTE 1: TEST MEDIUM TO BE H₂O - MINIMUM DURATION 10 MINUTES
NOTE 2: TEST MEDIUM TO BE AIR
NOTE 3: 10% MPI ON ALL FILLET WELDS INCLUDING PSV GUSSETS

PSV TAG#	LOCATION	MAKE	MODEL #	INLET	OUTLET	SET AT											
PSV-0501	STAGE #1 DISCHARGE	FARRIS	26FA12-140	1 1/2" - 300# RF	2" - 150# RF	4447.1 kPag @ 177C											
PSV-0502	STAGE #2 DISCHARGE	FARRIS	26FA13-140	1 1/2" - 600# RF	2" - 150# RF	4447.1 kPag @ 177C											

REVISIONS	ISSUE	DATE															
NO.																	
0	RELEASED FOR REGISTRATION	14-Oct-10															

PROFESSIONAL ENGINEER
ALBERTA
AFEWOK & ASSOCIATES
SEAL

APEGGA PERMIT: NO. P8651

HUSKY OIL OPERATIONS LTD
Site Name:: McMullen TCP
LSD: 03-35-078-25 W4
Waukesha F18GL
ARIEL JG/J2-1/2 STD
AIR-X-LIMITED 96AEF

Project No.
31834


Page No.
1 of 1

By:
CK

Checked:

Date:
14-Oct-10

ENERFLEX

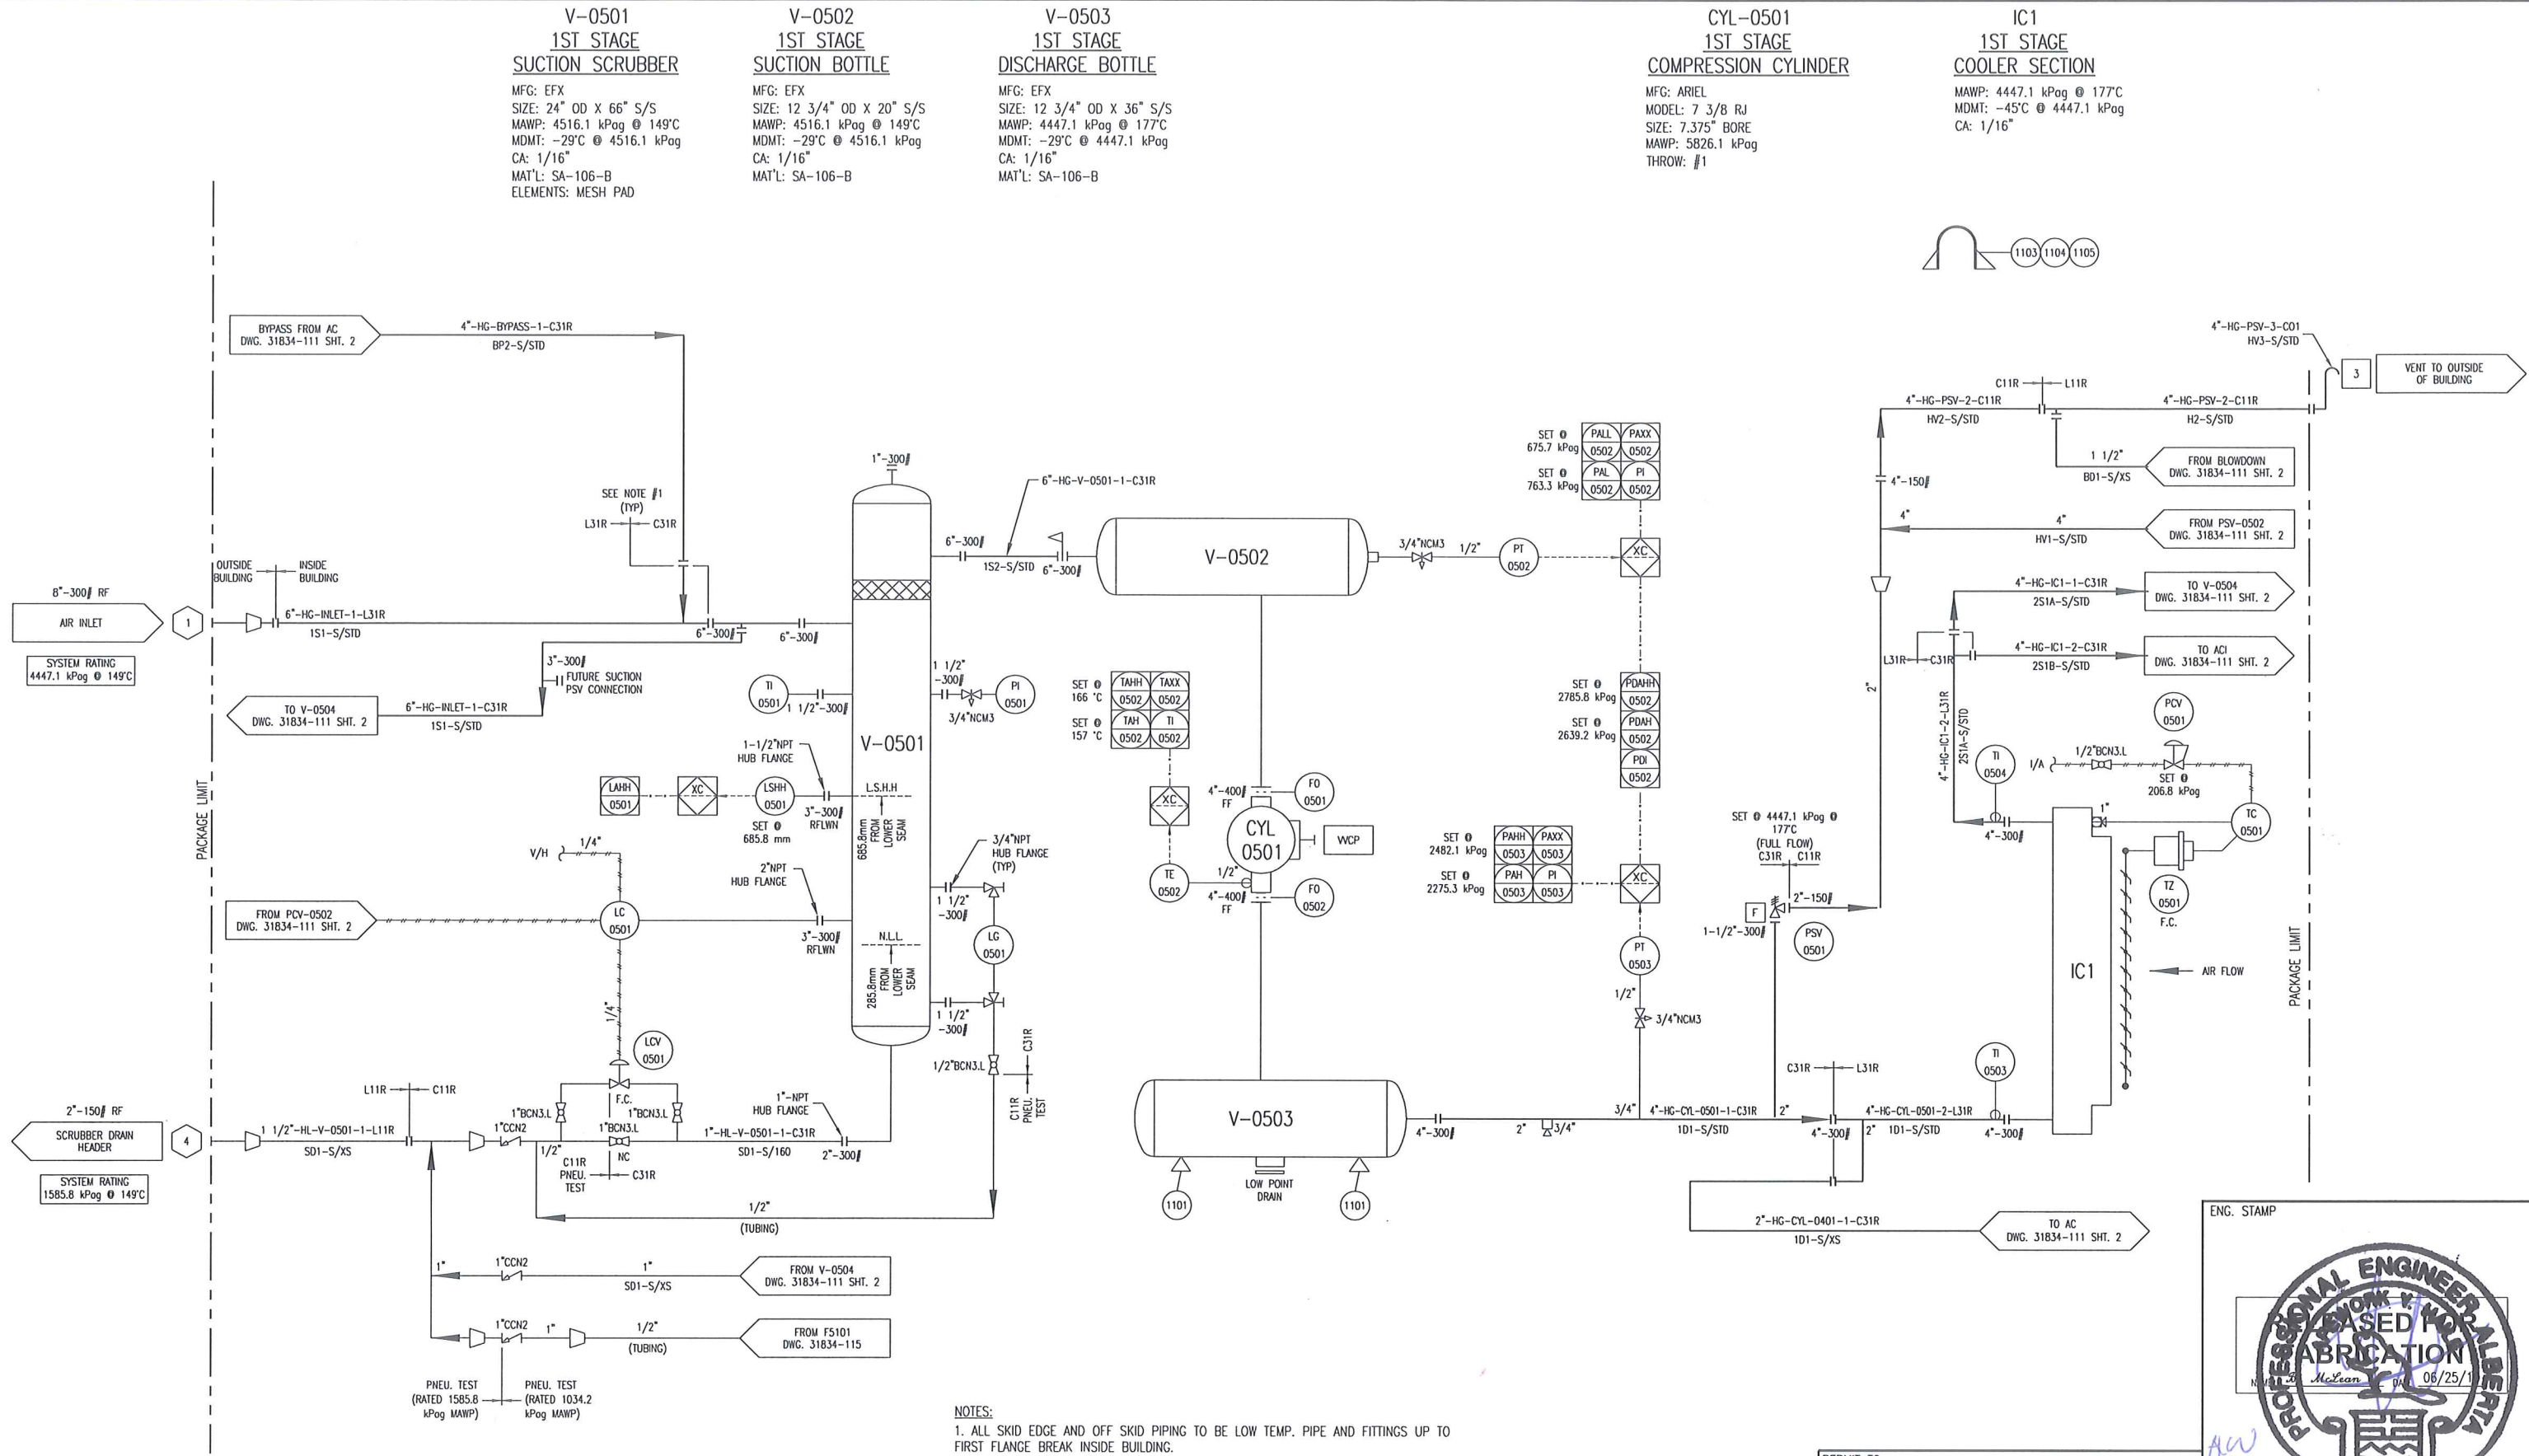


3	FOR REGISTRATION	11/22/10	JH	KC
2	HOT BYPASS REMOVED	09/16/10	JH	KC
1	ISSUED FOR FABRICATION	06/25/10	BM	DC
A	ISSUED FOR APPROVAL	06/04/10	CE	DC
REV	DESCRIPTION	DATE	BY	APR

DATE	06/04/10	SCALE	NTS
DRAWN BY	C. EMBROSE	CHECKED BY	X. BRENN
APPROVED BY	B. CAMPBELL	CUST PO	N/A
STEP CODE	198 490 511 591		

PERMIT TO PRACTISE	APEGGA PERMIT: No. P8651
FOR HUSKY OIL OPERATIONS LTD.	ENERFLEX
WAUKESHA F18GL	10121 - BARLOW TRAIL N.E. CALGARY ALBERTA CANADA
ARIEL JGJ/2-1/2 STD	

ENG. STAMP	
PROFESSIONAL ENGINEER ALBERTA	
REGISTERED	
DATE: 06/25/10	
TITLE	P & I DIAGRAM
	PROCESS GAS
	STAGE #1
DWG NO	31834-111
SHT	1
REV	3

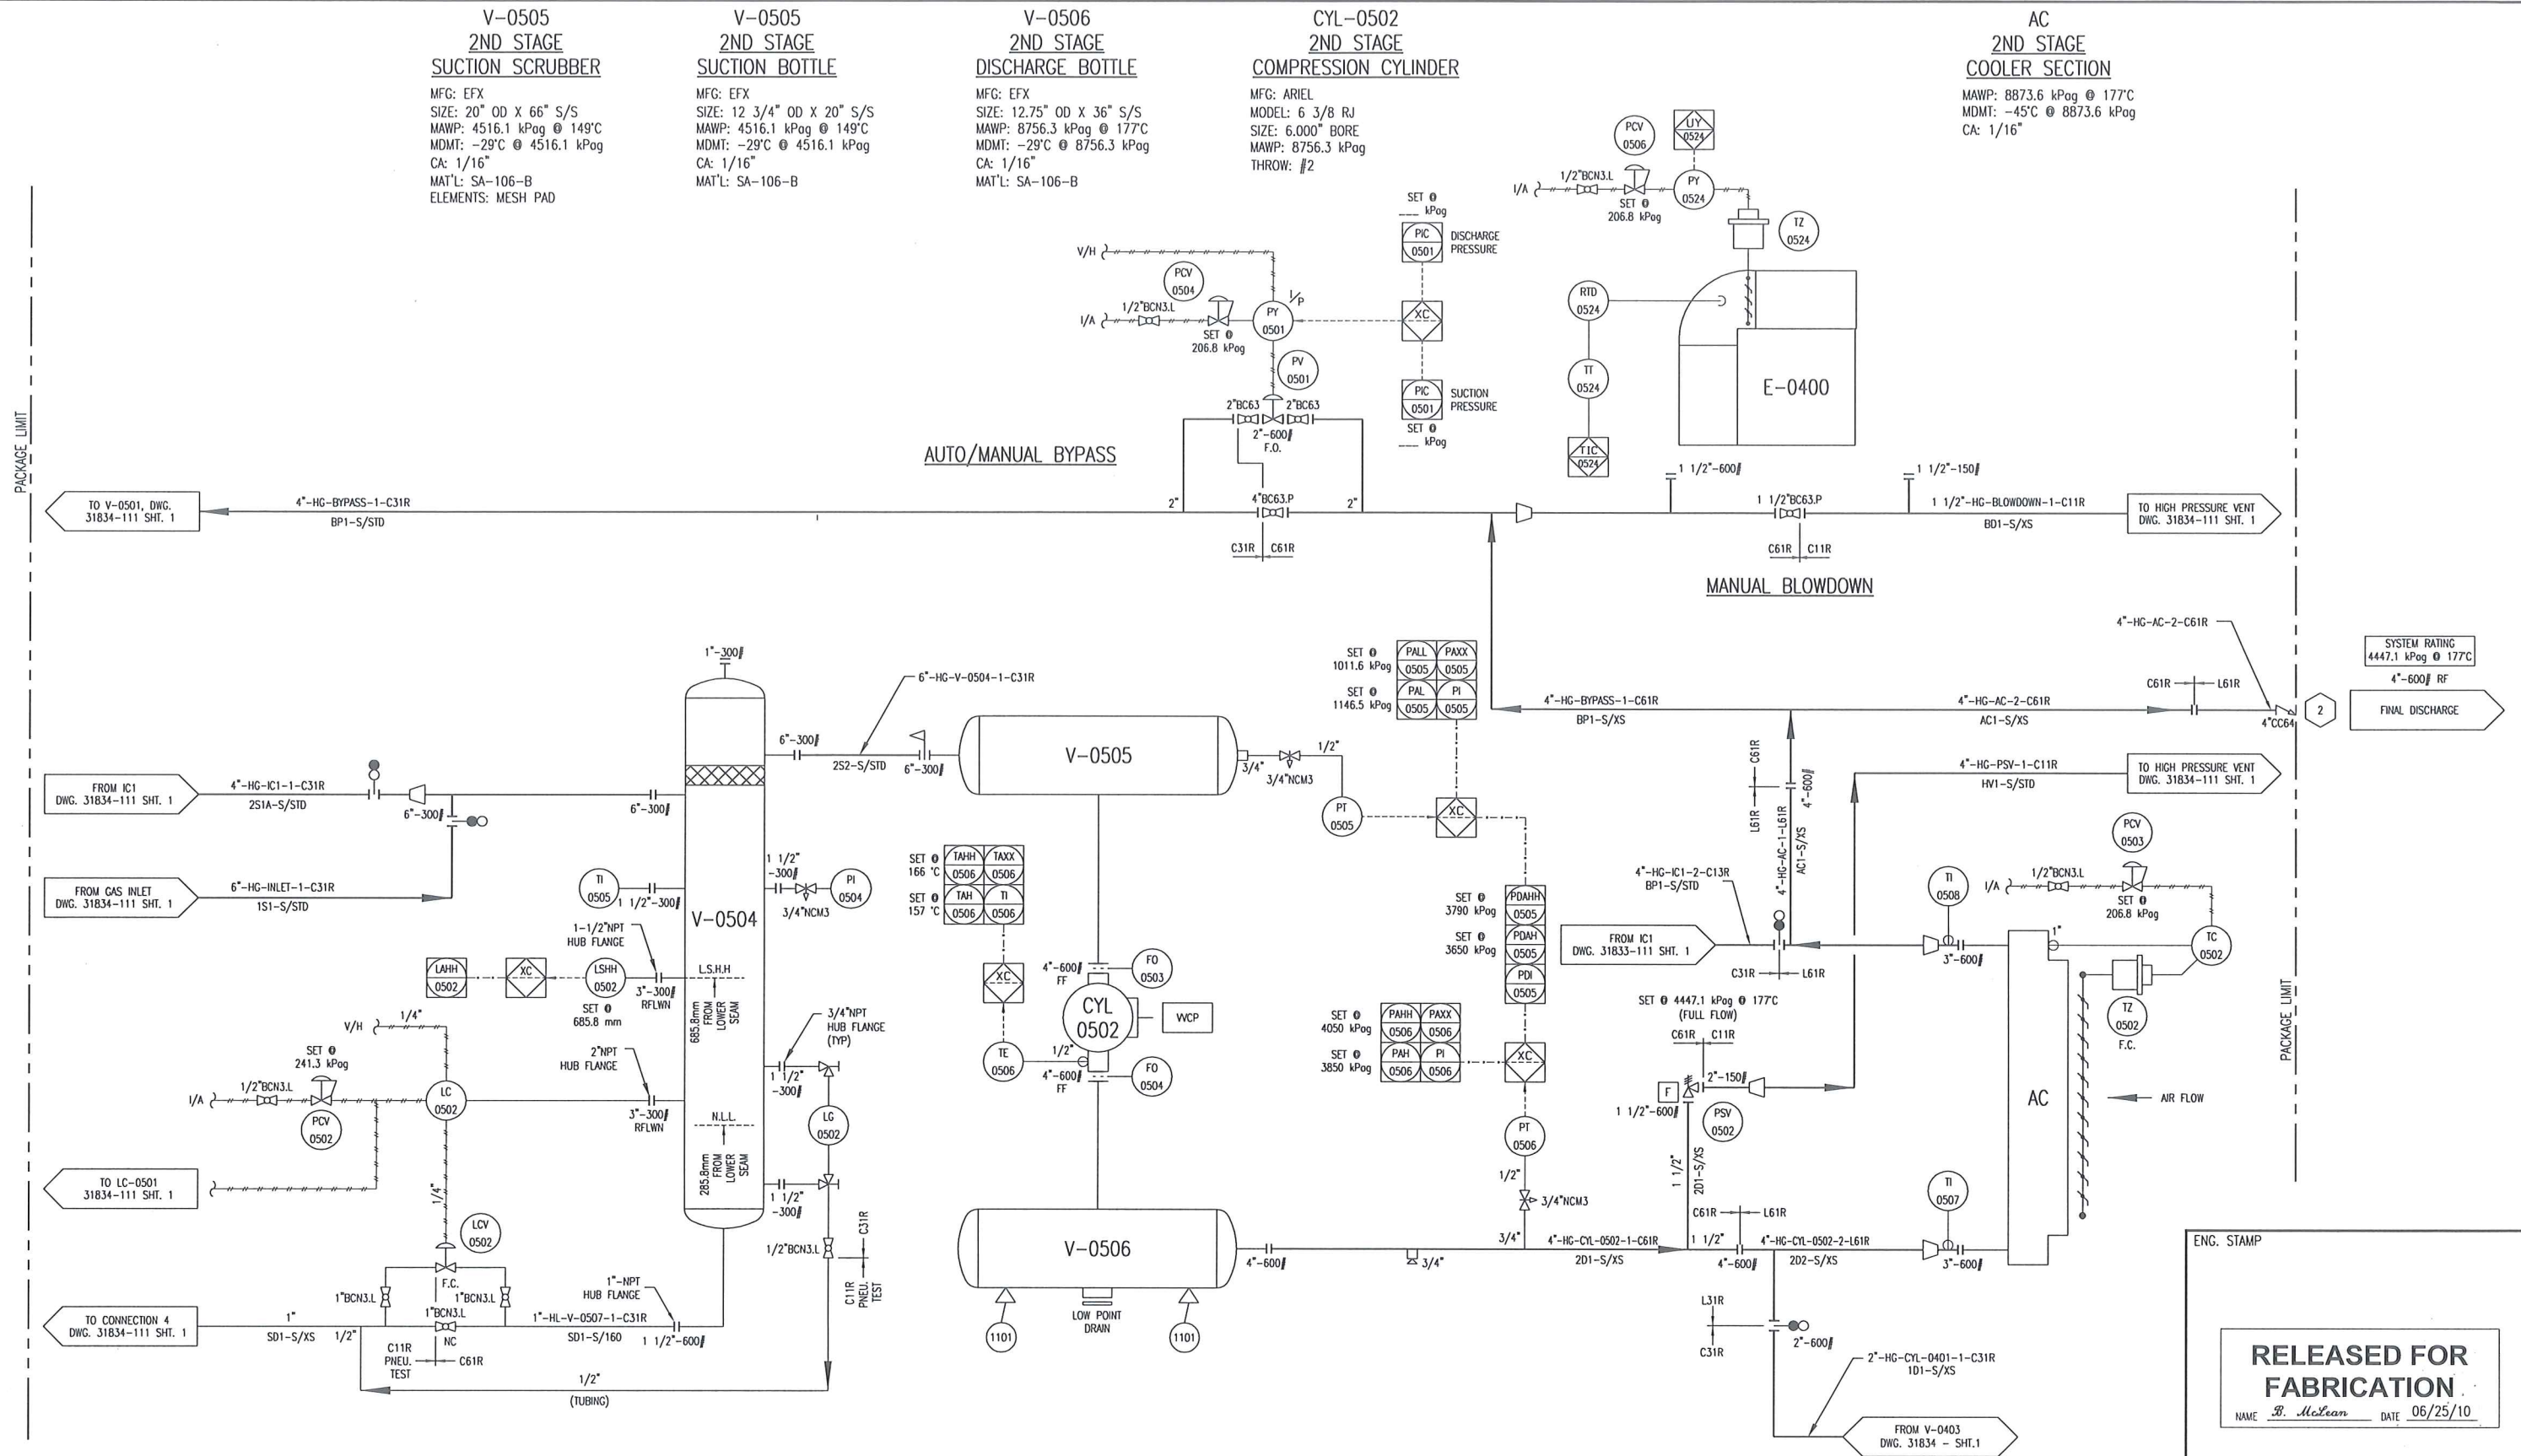

ENG. STAMP

RELEASED FOR FABRICATION

NAME B. McLean DATE 06/25/10

PERMIT TO PRACTISE APEGGA PERMIT: No. P8651

3	FOR REGISTRATION	11/22/10	JH	KG	DATE	06/04/10	SCALE	NTS
2	HOT BYPASS REMOVED	09/16/10	JH	KG	DRAWN BY	C. EAGAN	CHECKED BY	X. BRETEN
1	ISSUED FOR FABRICATION	06/25/10	BM	DC	APPROVED BY	B. CAMPBELL	CUST PO	N/A
A	ISSUED FOR APPROVAL	06/04/10	CE	DC	STEP CODE	198 490 511 591		
REV	DESCRIPTION	DATE	BY	APR				

FOR HUSKY OIL OPERATIONS LTD.
WAUKESHA F18GL
ARIEL JGJ/2-1/2 STD

ENERFLEX
10121 - BARLOW TRAIL N.E.
CALGARY ALBERTA CANADA

TITLE P & I DIAGRAM
PROCESS GAS
STAGE #2
DWG NO 31834-111
SHT 2
REV 3

C:\Users\lmcaden\TES\projects\local\temp\AcPublish_1860\31834-111-ASBUILT.dwg
PLDT DATE January 07, 2011

PROJECT DESCRIPTION

ONE (1) AIR COMPRESSOR PACKAGE
FOR: HUSKY OIL OPERATIONS LTD.
LOCATION NAME: MCMULLEN THERMAL CONDUCTION PILOT (TCP) PROJECT
LSD: 03-35-078-25 W4

FABRICATED BY:

ENERFLEX LTD.
CALGARY, ALBERTA, CANADA

TANK CAPACITIES

GLYCOL STORAGE TANK: 330 LITERS
WASTE OIL STORAGE TANK: 330 LITERS
CYLINDER LUBE OIL DAYTANK: 300 LITERS
COMPR./ENGINE LUBE OIL DAYTANK: 300 LITERS

EQUIPMENT LIST (EACH EQUIPMENT NUMBER IS PRECEDED WITH A FUNCTIONAL LOCATION CODE.)

TAG NO.	DESCRIPTION	P&ID
V-0501	STAGE 1 SUCTION SCRUBBER	31834-111 SHT. 1
V-0502	STAGE 1 SUCTION BOTTLE	31834-111 SHT. 1
V-0503	STAGE 1 DISCHARGE BOTTLE	31834-111 SHT. 1
V-0504	STAGE 2 SUCTION SCRUBBER	31834-111 SHT. 2
V-0505	STAGE 2 SUCTION BOTTLE	31834-111 SHT. 2
V-0506	STAGE 2 DISCHARGE BOTTLE	31834-111 SHT. 2
CYL-0501	STAGE 1 COMPRESSION CYLINDER	31834-111 SHT. 1
CYL-0502	STAGE 2 COMPRESSION CYLINDER	31834-111 SHT. 2
IC1	STAGE 1 COOLER SECTION	31834-111 SHT. 1
AC	STAGE 2 COOLER SECTION	31834-111 SHT. 2
CE-0501	ENGINE	31834-112 SHT. 1
K-0500	RECIPROCATING GAS COMPRESSOR FRAME	31834-112 SHT. 1
CP-0501	CONTROL PANEL	31834-112 SHT. 1
E-0500	COOLER FRAME	31834-112 SHT. 1
E-0501	COMPRESSOR FRAME OIL COOLER	31834-113 SHT. 1
FR-0500	COMPRESSOR FRAME OIL FILTER	31834-113 SHT. 1
P-0500	COMPRESSOR LUBE OIL PUMP	31834-113 SHT. 1
P-0501	COMPRESSOR FRAME OIL PUMP	31834-113 SHT. 1
T-0500	LUBE OIL DAYTANK	31834-113 SHT. 1
T-0501	WASTE OIL TANK	31834-113 SHT. 1
T-0502	COMPRESSOR/ENGINE OIL DAYTANK	31834-114 SHT. 1
T-0503	WASTE GLYCOL TANK	31834-116 SHT. 1
T-0504	GLYCOL (EJW) SURGE TANK	31834-116 SHT. 1
T-0505	GLYCOL (AJW) SURGE TANK	31834-116 SHT. 2
P-0502	EJW PUMP	31834-116 SHT. 1
P-0503	AJW PUMP	31834-116 SHT. 2
EJW	EJW COOLER	31834-116 SHT. 1
AJW	AJW COOLER	31834-116 SHT. 2
FR-0501	AIR FILTER HOUSING	31834-117 SHT. 1

POWER REQUIREMENTS

ENGINE IGNITION SYSTEM: VOL: 24 VDC
CONTROL PANEL: VOL: 24 VDC
FIRE DETECTION: VOL: 24 VDC
LEL DETECTION: VOL: 24 VDC
LIGHTS: VOL: 120 VAC
BUILDING HEATERS: VOL: 120 VAC
BUILDING FANS: VOL: 115 VAC
IMMERSION HEATERS: VOL: 120 VAC

SYSTEM CONSUMABLES

COMPRESSOR CRANKCASE LUBE OIL: ESSO GMA40, LOW ASH, 22.7 LITERS
COMPRESSOR CYLINDER LUBE OIL: ISO 100 SYNTHETIC, LOW ASH
ENGINE CRANKCASE LUBE OIL: ESSO GMA40, LOW ASH, 166.6 LITERS
NORKOOL, 50% ETHYLENE INHIBITED GLYCOL/WATER SOLUTION
IN ENGINE & AUXILIARY JACKED WATER SYSTEMS
EJW CAPACITY: 208 LITERS
AJW CAPACITY: 95 LITERS

DESIGN SPECIFICATION:

ENERFLEX LTD. (EFX) SCOPE OF SUPPLY ON THIS PROJECT CONSISTS OF ONE SKIDDED GAS COMPRESSOR PACKAGE.

PACKAGE CONSISTS OF ONE (1) WAUKESHA F18GL ENGINE DRIVING AN ARIEL JGJ/2, ONE/TWO STAGE, AIR COMPRESSOR.

PRIMER: -TPS-SP-001, FIN-1, RED OXIDE
PAINT: -TPS-SP-001, FIN-1, 20-F "WARM GREY"
PROCESS PIPING: -10% RADIOGRAPHIC TESTING
-10% MT ON FILLET WELDS
-1/16" CORROSION ALLOWANCE
-NO PWHT
-SSPC-SP3
-SPOOLING BETWEEN CONE STRAINER AND COMPRESSOR SUCTION FLANGE SANDBLASTED INTERNALLY SSPC-SP6
-NO PICKLING
-NDE INTERPRETATION TO BE CGSB
-MTR'S REQUIRED
-5% RADIOGRAPHIC TESTING
-10% MT ON FILLET WELDS
-NO PWHT
-SSPC-SP3
-SUCTION VESSELS BETWEEN CONE STRAINER AND COMPRESSOR SUCTION FLANGE SANDBLASTED INTERNALLY SSPC-SP6
-NO PICKLING
-NDE INTERPRETATION TO BE CGSB
-MTR'S REQUIRED

VESSELS:

DESIGN CRITERIA & APPLICABLE CODES

SITE ELEVATION: 1886 FT ABOVE MEAN SEA LEVEL
BAROMETRIC PRESSURE: 94.518 KPAA
AMBIENT TEMPERATURE: MAXIMUM 37.8°C
MINIMUM -45°C
WIND SPEED: MAXIMUM 160 km/hr
PROCESS INLET: DESIGN 4447.1 KPAG @ 149°C
PROCESS FINAL DISCHARGE: DESIGN 8756.3 KPAG @ 177°C
INSTRUMENT GAS: MINIMUM PRESSURE 344.7 KPAG
MAXIMUM PRESSURE 1034.2 KPAG
QUALITY FILTERED/DRY, 50°F MAXIMUM DEW POINT
APPLICABLE CODE: CODE PIPING B31.3 - LATEST EDITION
NON-CODE PIPING TESI C01, 1mm CA
VESSEL ASME SECTION VIII
EXCHANGER ASME SECTION VIII
STRUCTURAL AWS D1.1
ELECTRICAL CEC
VESSEL AB, BC, SASK
GASKETS CG TYPE, SPIRAL WOUND, CHLOROCARB FILLED, 316SS
PROCESS PIPE CARBON STEEL
UTILITY PIPE CARBON STEEL
FLANGES RAISED FACE (UNLESS OTHERWISE NOTED)
ORIFICE PLATES PER ACOUSTICAL STUDY
THREAD SEALANT JETLUBE ONLY (SWAK NOT PERMITTED)
PROCESS TUBING - 316(SS) SMLS, 3/8" MIN Ø
FITTINGS - 316(SS)
FERRULES - 316(SS)
UTILITY TUBING - 304(SS) SMLS
FITTINGS - ZINC PLATED CS
FERRULES - 316(SS) BACK / CS FRONT
TUBING - 316(SS) SMLS
FITTINGS - ZINC PLATED (SS FERRULES)
FRAME INTERNALS RIGID ALUMINUM CONDUIT
CLASS 1, DIV 2, GROUP D
ELECTRICAL: SUITABLE FOR USE IN:

					PERMIT TO PRACTISE APEGGA PERMIT: No. P8651				ENG. STAMP	
					DATE 06/04/10		SCALE NTS		FOR HUSKY OIL OPERATIONS LTD.	
					DRAWN BY C. Eadsforth		CHECKED BY X. Breen		APPROVED BY J. Campbell	
					1 ISSUED FOR FABRICATION		06/25/10		BM DC	
					A ISSUED FOR APPROVAL		06/04/10		CE DC	
					REV DESCRIPTION		DATE		BY APR	
					STEP CODE N/A					
									10121 - BARLOW TRAIL N.E. CALGARY ALBERTA CANADA	
									DWG NO 31834-099	
									SHT 1	
									REV 3	


ENG. STAMP

CERTIFIED AS BUILT

NAME B. McLean DATE 12/21/10


TITLE P & I DIAGRAM
PROJECT DESCRIPTION
AND OVERVIEW

THE INFORMATION CONTAINED HEREIN IS THE CONFIDENTIAL PROPERTY OF TOROMONT ENERGY SYSTEMS AND IS NOT FOR PUBLICATION, AND NO PART THEREOF SHALL BE COPIED OR COMMUNICATED TO A THIRD PARTY WITHOUT AUTHORIZATION FROM TOROMONT ENERGY SYSTEMS.

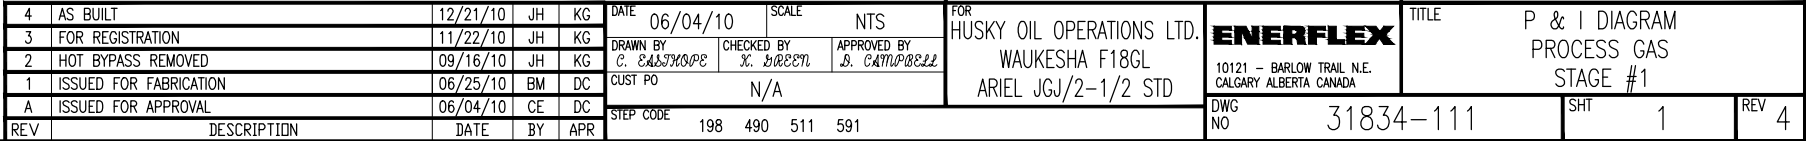

THE INFORMATION CONTAINED HEREIN IS THE CONFIDENTIAL PROPERTY OF TOROMONT ENERGY SYSTEMS AND IS NOT FOR PUBLICATION, AND NO PART THEREOF SHALL BE COPIED OR COMMUNICATED TO A THIRD PARTY WITHOUT AUTHORIZATION FROM TOROMONT ENERGY SYSTEMS.

PLDT DATE January 07, 2011 C:\Users\janderson\Documents\ES\appdata\local\Temp\KCPublish_1860\31834-111-ASBUILT.dwg

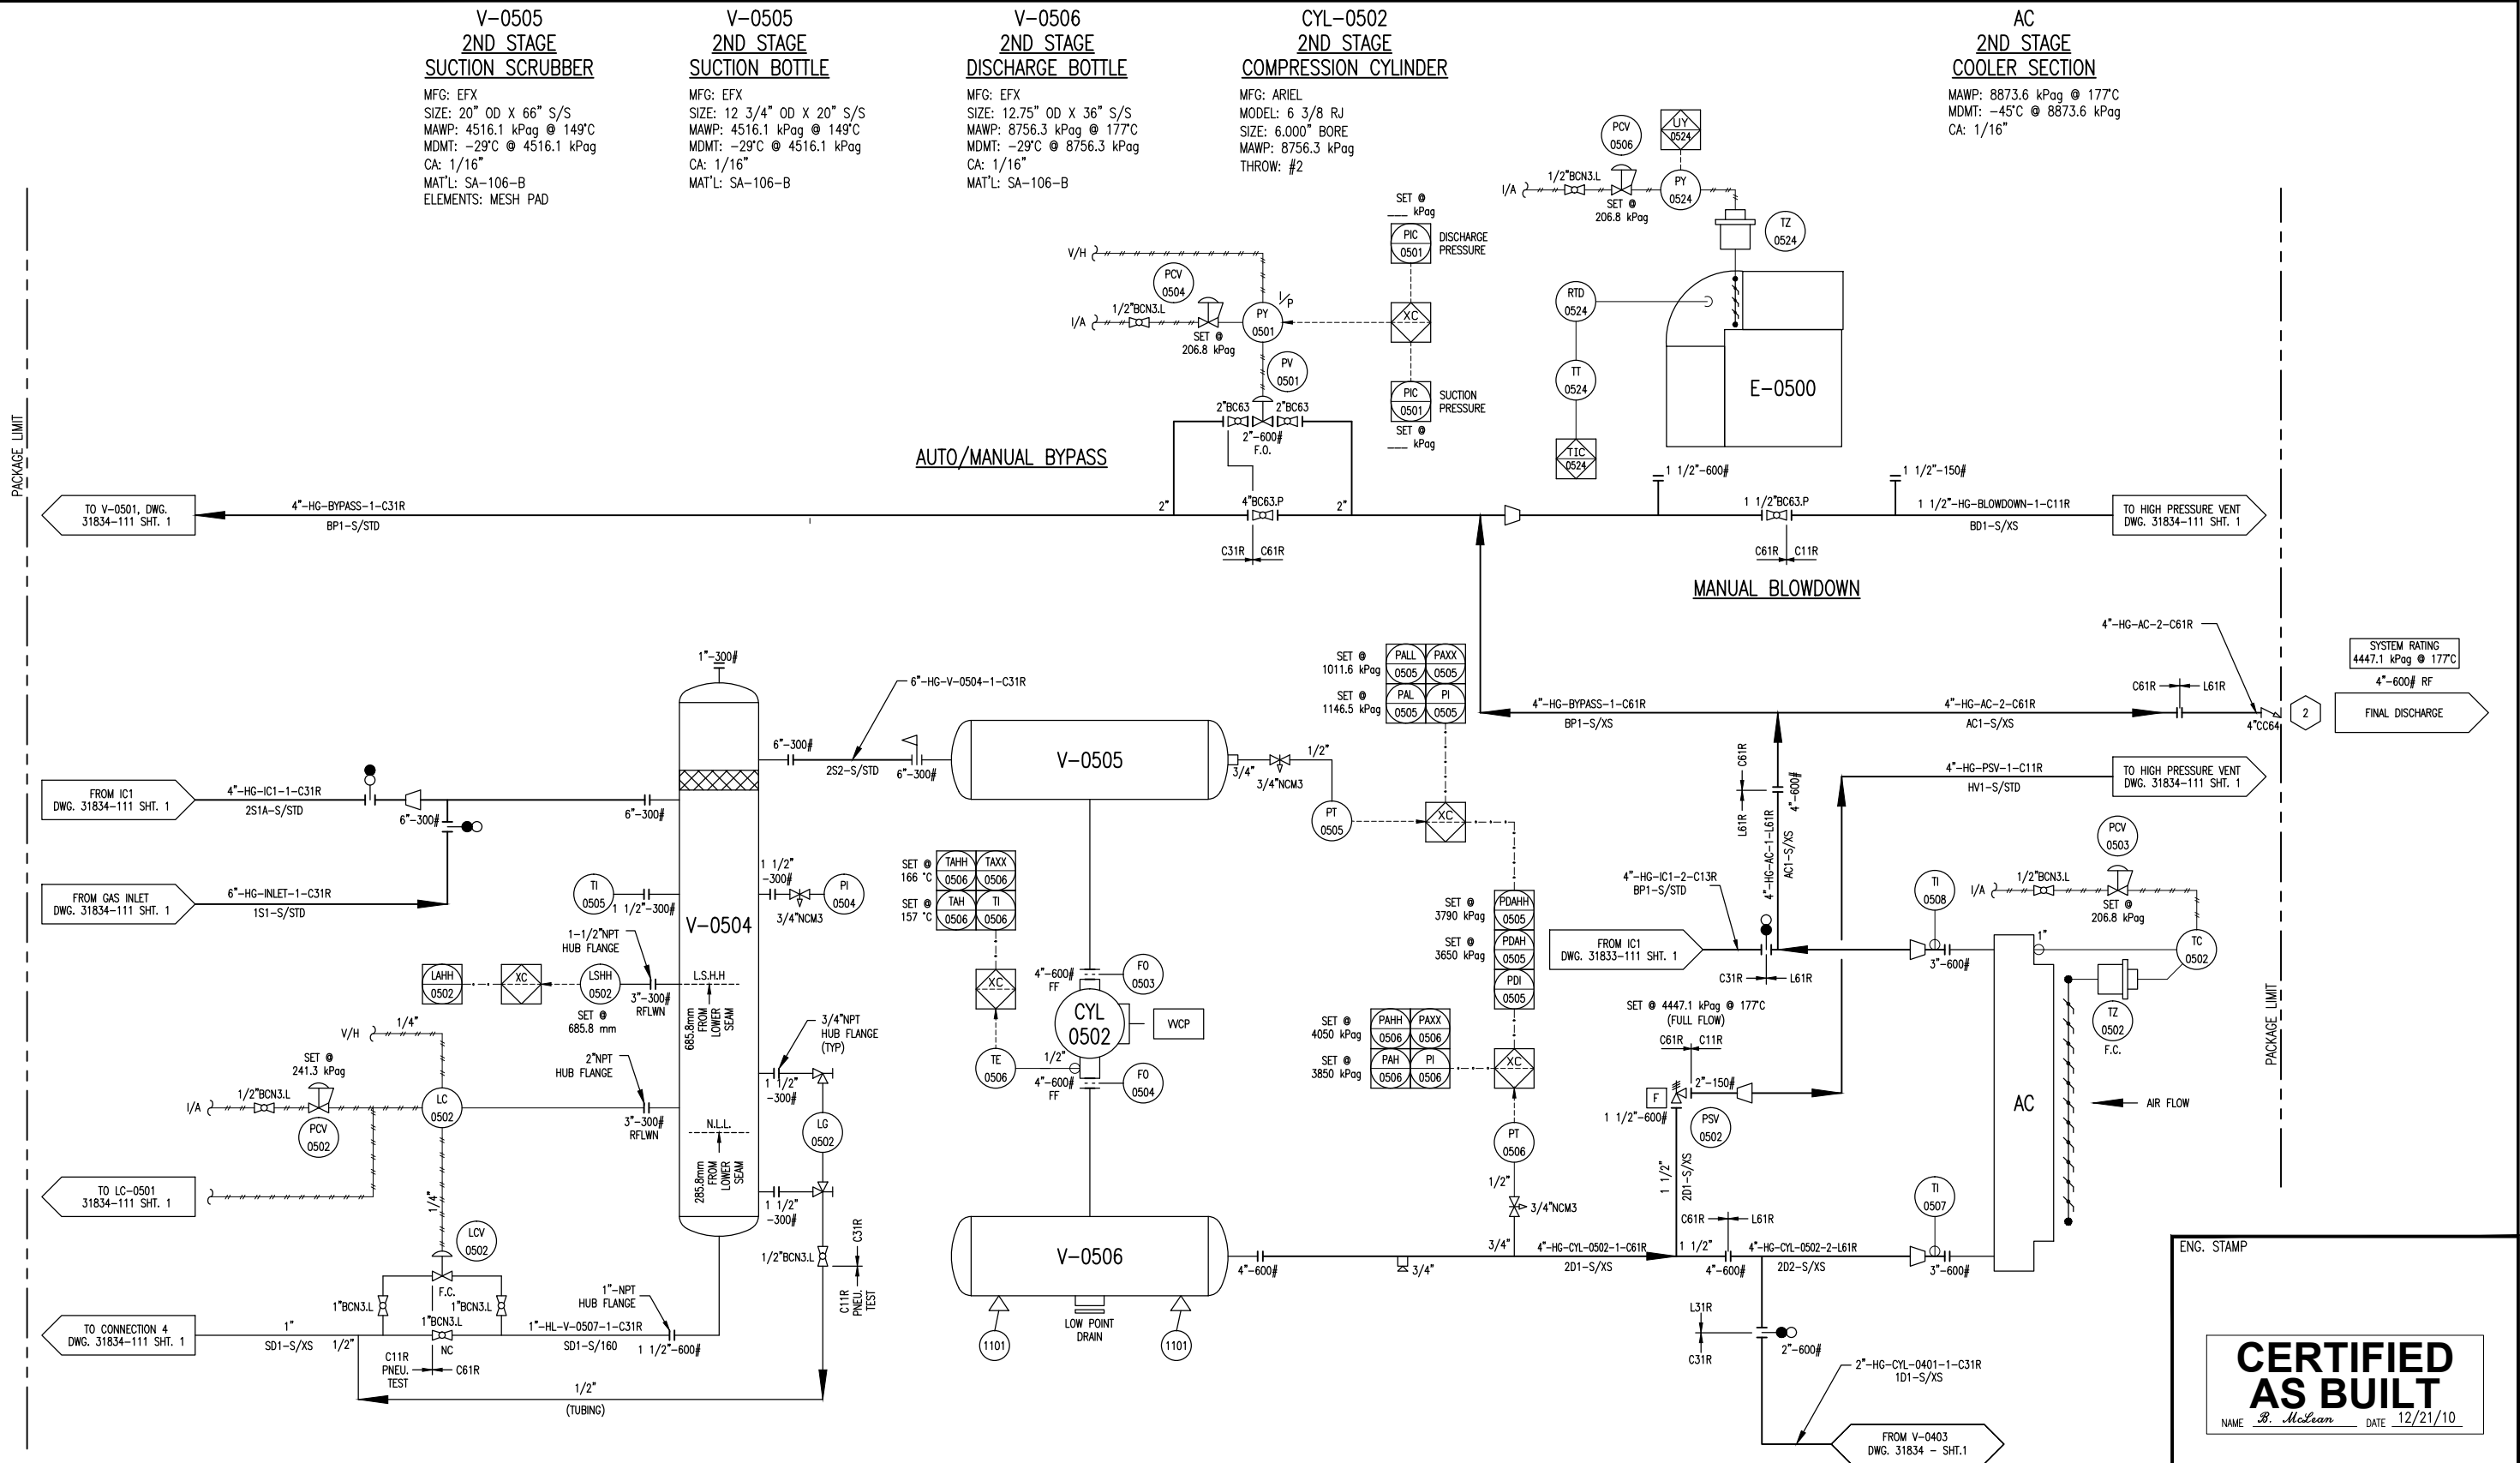

4	AS BUILT	12/21/10	JH	KG	DATE	06/04/10	SCALE	NTS
3	FOR REGISTRATION	11/22/10	JH	KG	DRAWN BY	C. Campbell	CHECKED BY	B. Green
2	HOT BYPASS REMOVED	09/16/10	JH	KG	APPROVED BY	B. Campbell		
1	ISSUED FOR FABRICATION	06/25/10	BM	DC	CUST PO	N/A		
A	ISSUED FOR APPROVAL	06/04/10	CE	DC	STEP CODE	198 490 511 591		
REV	DESCRIPTION	DATE	BY	APR				

PERMIT TO PRACTISE APEGGA PERMIT: No. P8651

FOR HUSKY OIL OPERATIONS LTD.
WAUKESHA F18GL
ARIEL JGJ/2-1/2 STD

ENERFLEX

10121 - BARLOW TRAIL N.E.
CALGARY ALBERTA CANADA

DWG NO 31834-111

ENG. STAMP

CERTIFIED AS BUILT

NAME B. McLean DATE 12/21/10

TITLE P & I DIAGRAM
PROCESS GAS
STAGE #2

SHT 2

REV 4

THE INFORMATION CONTAINED HEREIN IS THE CONFIDENTIAL PROPERTY OF TOROMONT ENERGY SYSTEMS AND IS NOT FOR PUBLICATION, AND NO PART THEREOF SHALL BE COPIED OR COMMUNICATED TO A THIRD PARTY WITHOUT AUTHORIZATION FROM TOROMONT ENERGY SYSTEMS.

PACKAGE LIMIT

K-0500
RECIPROCATING GAS
COMPRESSOR FRAME
MFG: ARIEL
MODEL: JGJ/2
RATED POWER: 620 HP @ 1800 RPM
STROKE: 3.50 in.
ROD LOAD, TOTAL: 42,000 lbs.
ROD LOAD, COMPRESSION: 23,000 lbs.
ROD LOAD, TENSION: 21,000 lbs.

KBU-0500
BUILDING EXHAUST FAN
MFG: SOPELPOWER:
POWER: 115 VAC, 4.8A
(WIRED TO JBP-0501)

CE-0501
COMPRESSOR ENGINE
MFG: WAUKESHA
MODEL: F18GL
BORE: 5.98"
STROKE: 6.5"
DISPLACEMENT: 1096 IN CU.
COMP RATIO: 8.7:1
POWER: 400 BHP @ 1800 RPM







CP-0500
CONTROL PANEL
MFG: EFX
POWER: 24 VDC
PROCESSOR: COMPACT LOGIX

JBP-0500
JUNCTION BOX
MFG: EFX
FOR: 120 VAC

JBC-0500
JUNCTION BOX
MFG: EFX
FOR: 24DC DISCRETE SIGNALS

JBA-0500
JUNCTION BOX
MFG: EFX
FOR: ANALOGS





E-0500
PACKAGE GAS COOLER FRAME
MFG: AIR-X-LIMITED
MODEL: 96AEF
TYPE: FORCED DRAFT
AIR FLOW: 82,740 SCFM
FAN TYPE: 1 MOORE 96DIA. X 6 BLADE
FAN POWER: 21.3 BHP @ 418 RPM
AMBIENT AIR: 40°C
EXIT AIR: 54°C

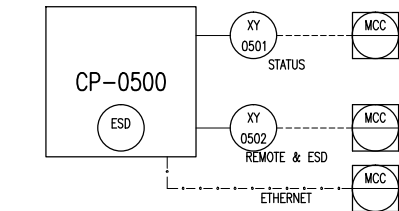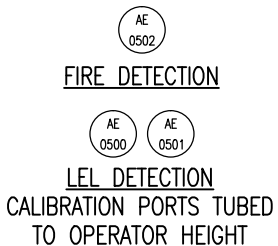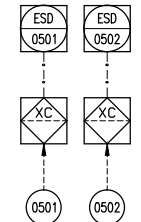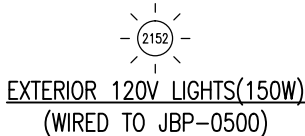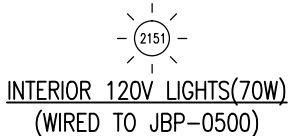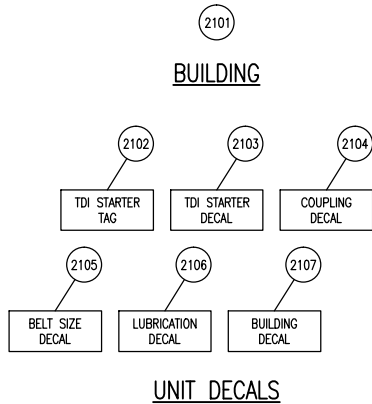




BUILDING RECEPTACLE

(2155)

(2155)

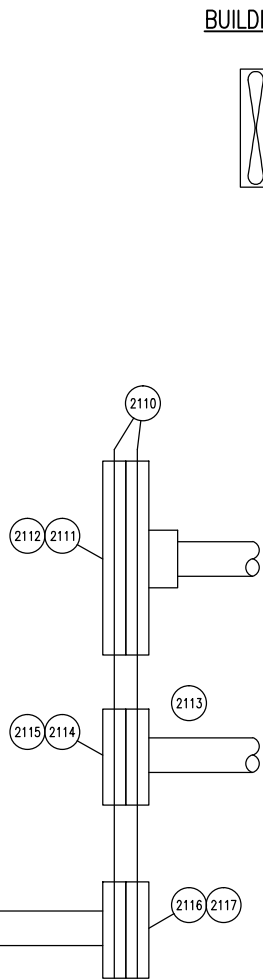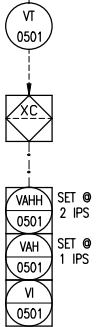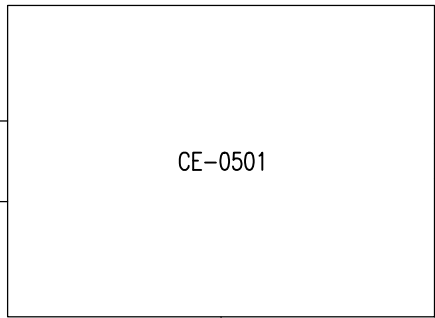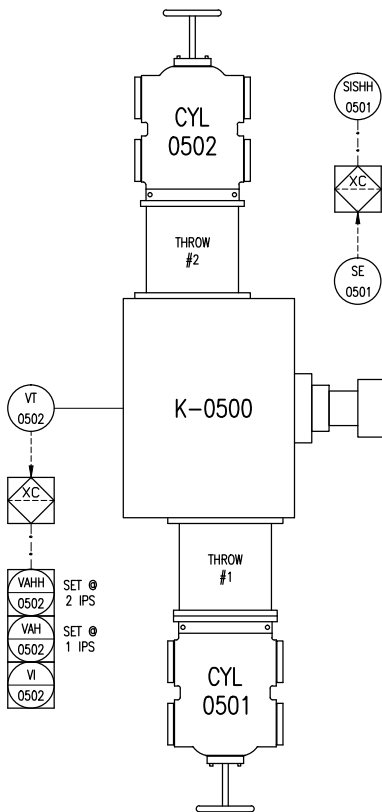

BUILDING EXHAUST FAN
KBU- 500

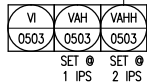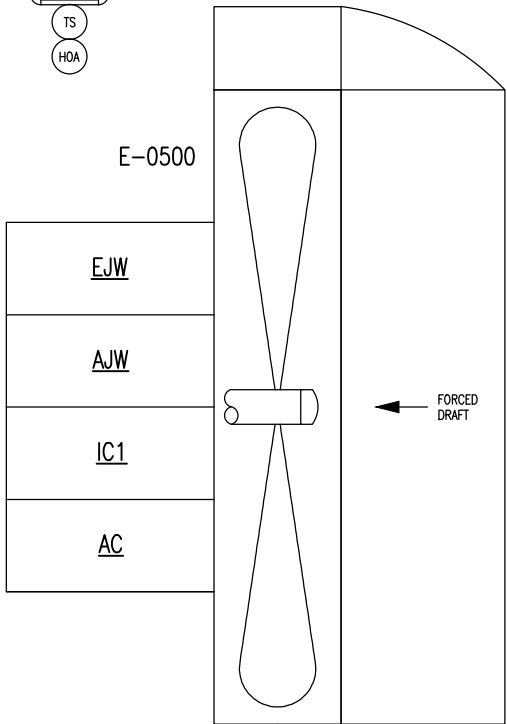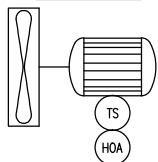

FROM FSL-0501
DWG. 31834-113



PACKAGE LIMIT

4	AS BUILT	12/21/10	JH	KG	DATE	06/04/10	SCALE	NTS
3	FOR REGISTRATION	11/22/10	JH	KG	DRAWN BY	C. EASBY/PE	CHECKED BY	X. BERRY
2	REVISED AS PER CUSTOMER MARK UP	09/16/10	JH	KG	APPROVED BY	B. CAMPBELL		
1	ISSUED FOR FABRICATION	06/25/10	BM	DC	CUST PO	N/A		
A	ISSUED FOR APPROVAL	06/04/10	CE	DC	STEP CODE	151 198 511 712 721		
REV	DESCRIPTION	DATE	BY	APR				

PERMIT TO PRACTISE APEGGA PERMIT: No. P8651

FOR HUSKY OIL OPERATIONS LTD.
WAUKESHA F18GL
ARIEL JGJ/2-1/2 STD

ENERFLEX

10121 - BARLOW TRAIL N.E.
CALGARY ALBERTA CANADA

DWG NO 31834-112

ENG. STAMP



CERTIFIED AS BUILT
NAME *B. McLean* DATE 12/21/10

TITLE P & I DIAGRAM
DRIVE TRAIN / CONTROL PANEL

SHT 1

REV 4

C:\Users\jmclean\Documents\Projects\31834-111-ASBUILT.dwg
PLDT DATE January 07, 2011

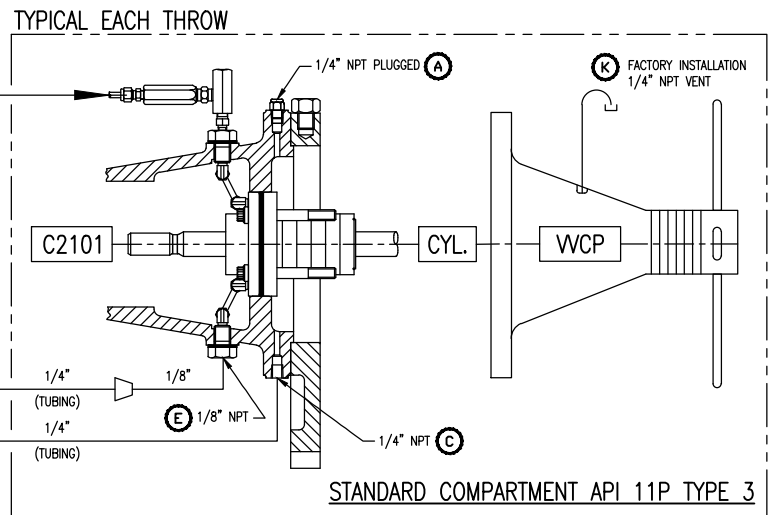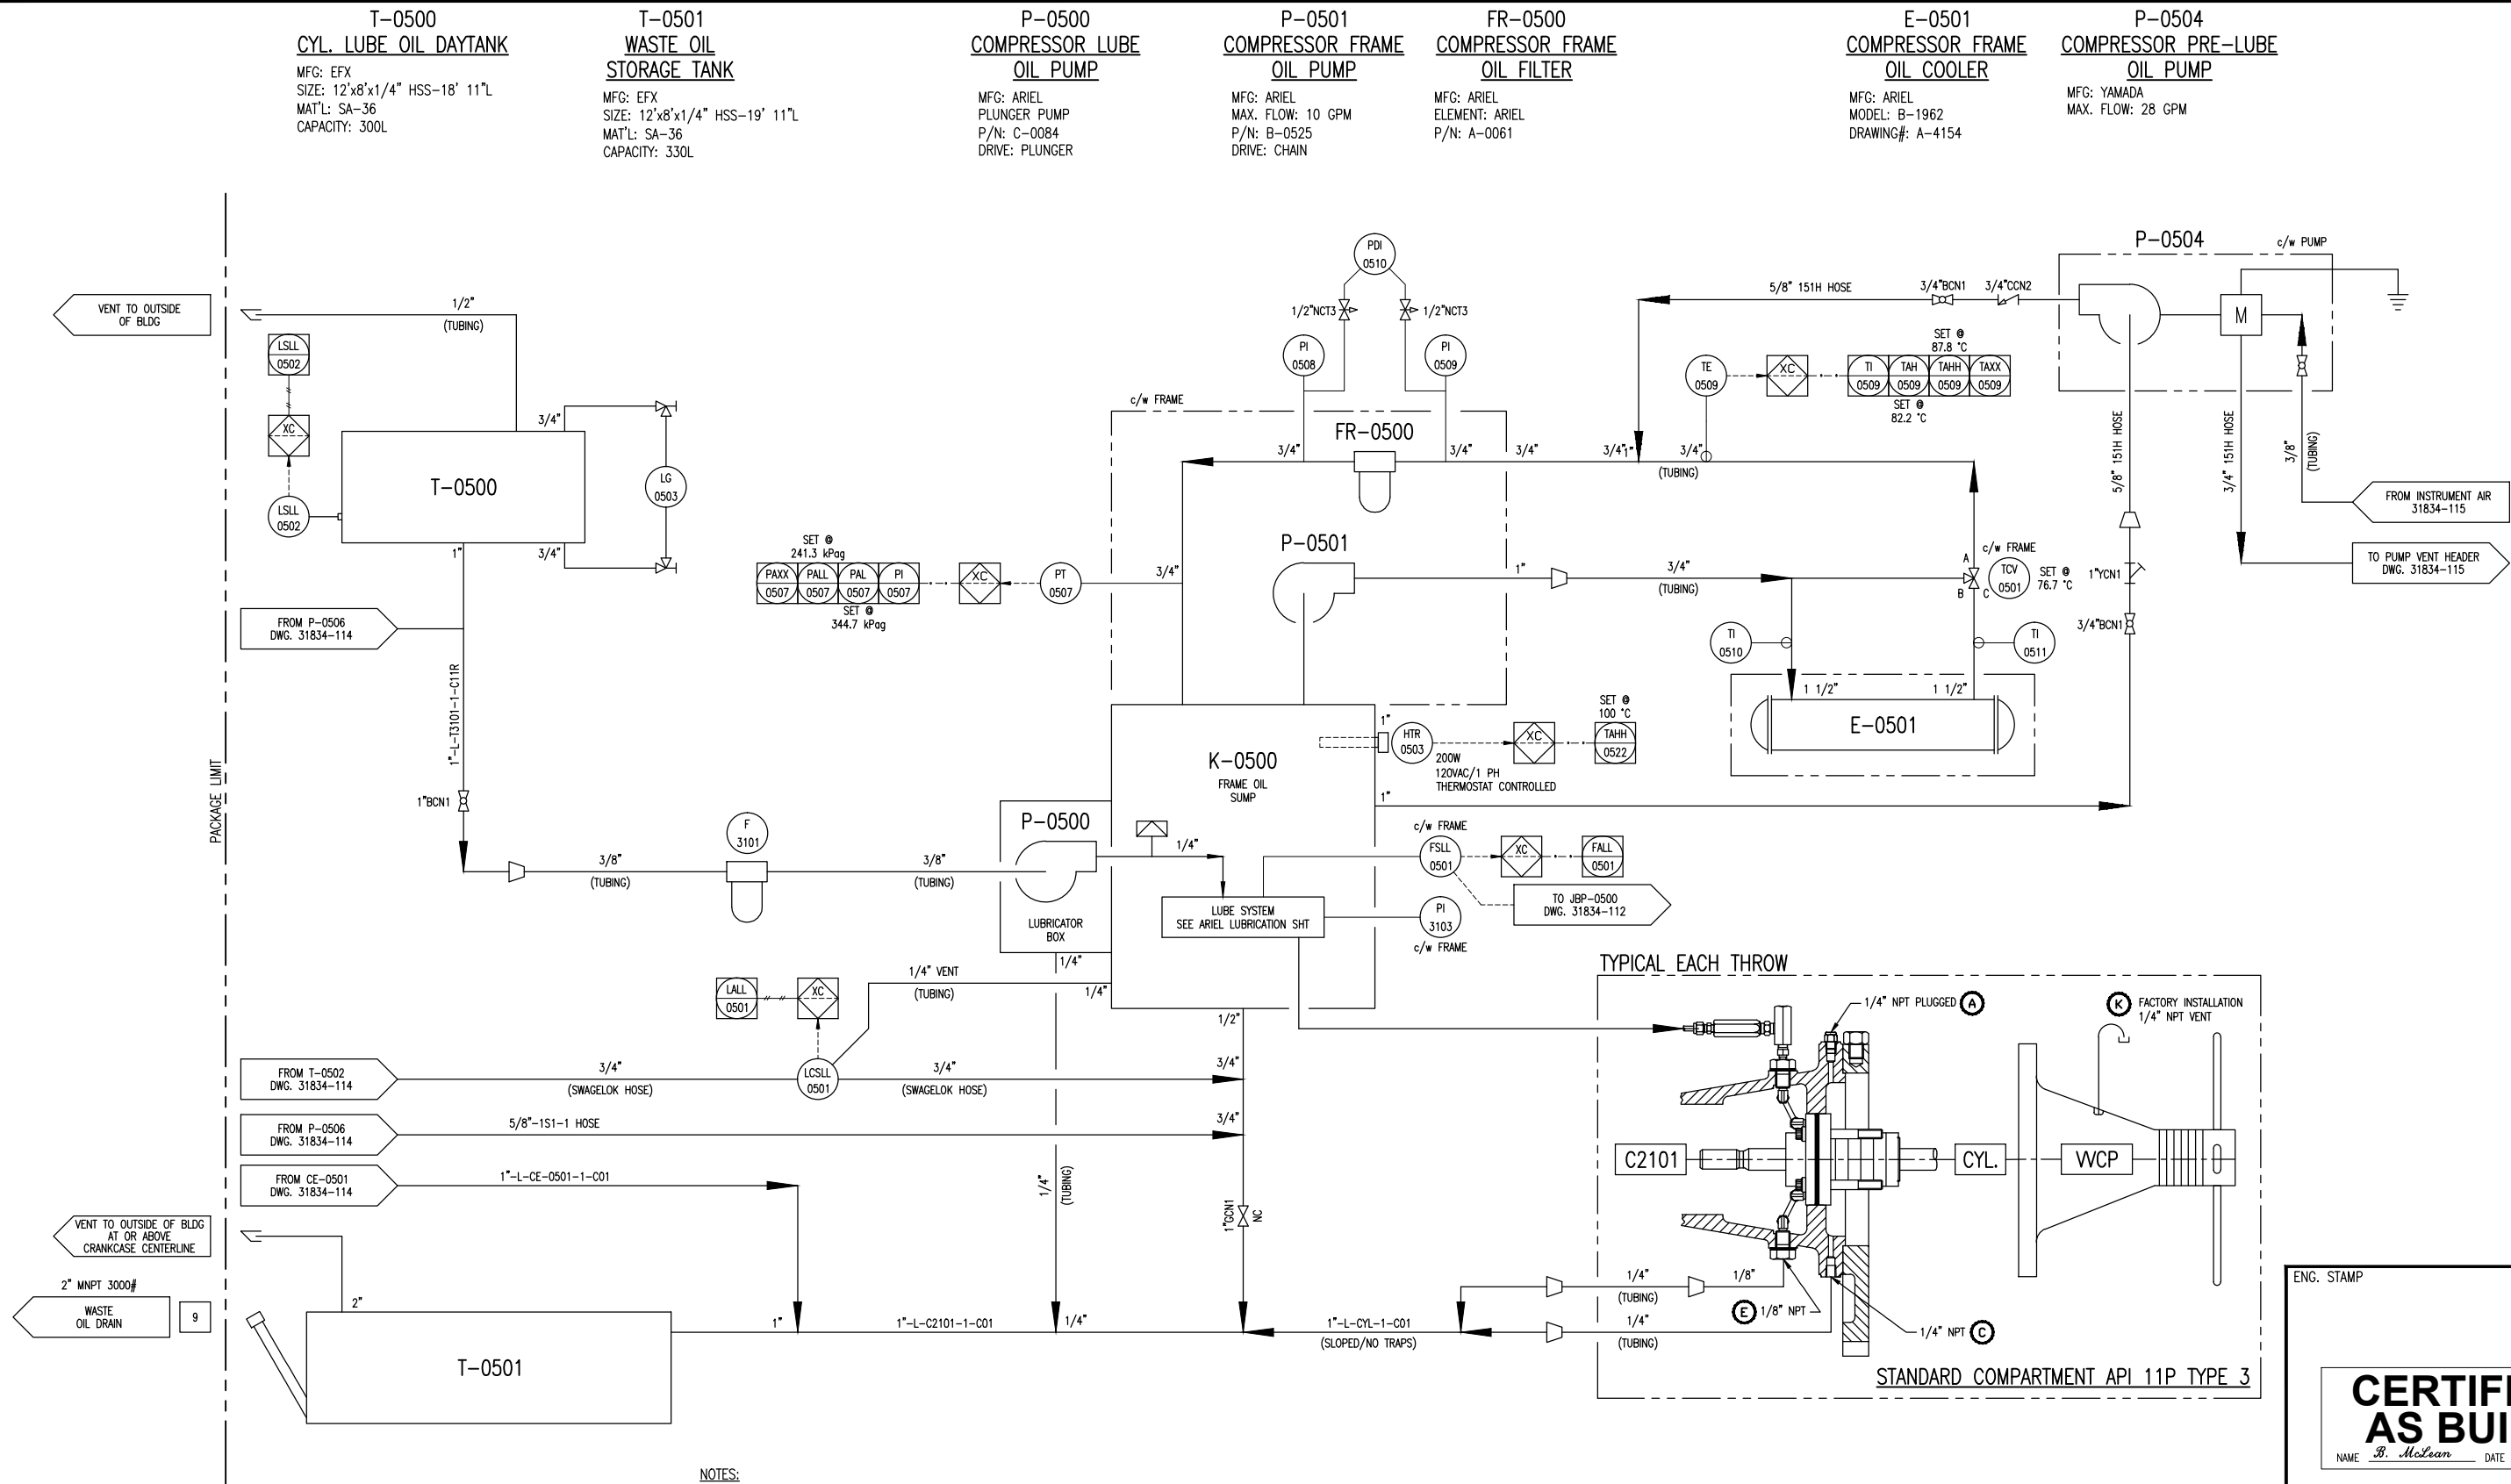


ENG. STAMP

CERTIFIED AS BUILT

NAME B. McLean DATE 12/21/10

										PERMIT TO PRACTISE		APEGGA PERMIT: No. P8651															
4	AS BUILT	12/21/10	JH	KG	DATE	06/04/10	SCALE	NTS	FOR	HUSKY OIL OPERATIONS LTD.			ENERFLEX 10121 - BARLOW TRAIL N.E. CALGARY ALBERTA CANADA	TITLE					P & I DIAGRAM COMPRESSOR LUBE OIL / UTILITIES								
3	FOR REGISTRATION	11/22/10	JH	KG	DRAWN BY	C. CAMPBELL	CHECKED BY	X. BREEN	APPROVED BY	D. CAMPBELL																	
2	REVISED AS PER CUSTOMER MARK UP	09/16/10	JH	KG	CUST PO			N/A			WAUKESHA F18GL																
1	ISSUED FOR FABRICATION	06/25/10	BM	DC							ARIEL JGJ/2-1/2 STD																
A	ISSUED FOR APPROVAL	06/04/10	CE	DC																							
REV	DESCRIPTION		DATE		BY		APR		STEP CODE			198 511 591			DWG NO		31834-113			SHT		1		REV		4	

THE INFORMATION CONTAINED HEREIN IS THE CONFIDENTIAL PROPERTY OF TOROMONT ENERGY SYSTEMS AND IS NOT FOR PUBLICATION, AND NO PART THEREOF SHALL BE COPIED OR COMMUNICATED TO A THIRD PARTY WITHOUT AUTHORIZATION FROM TOROMONT ENERGY SYSTEMS.

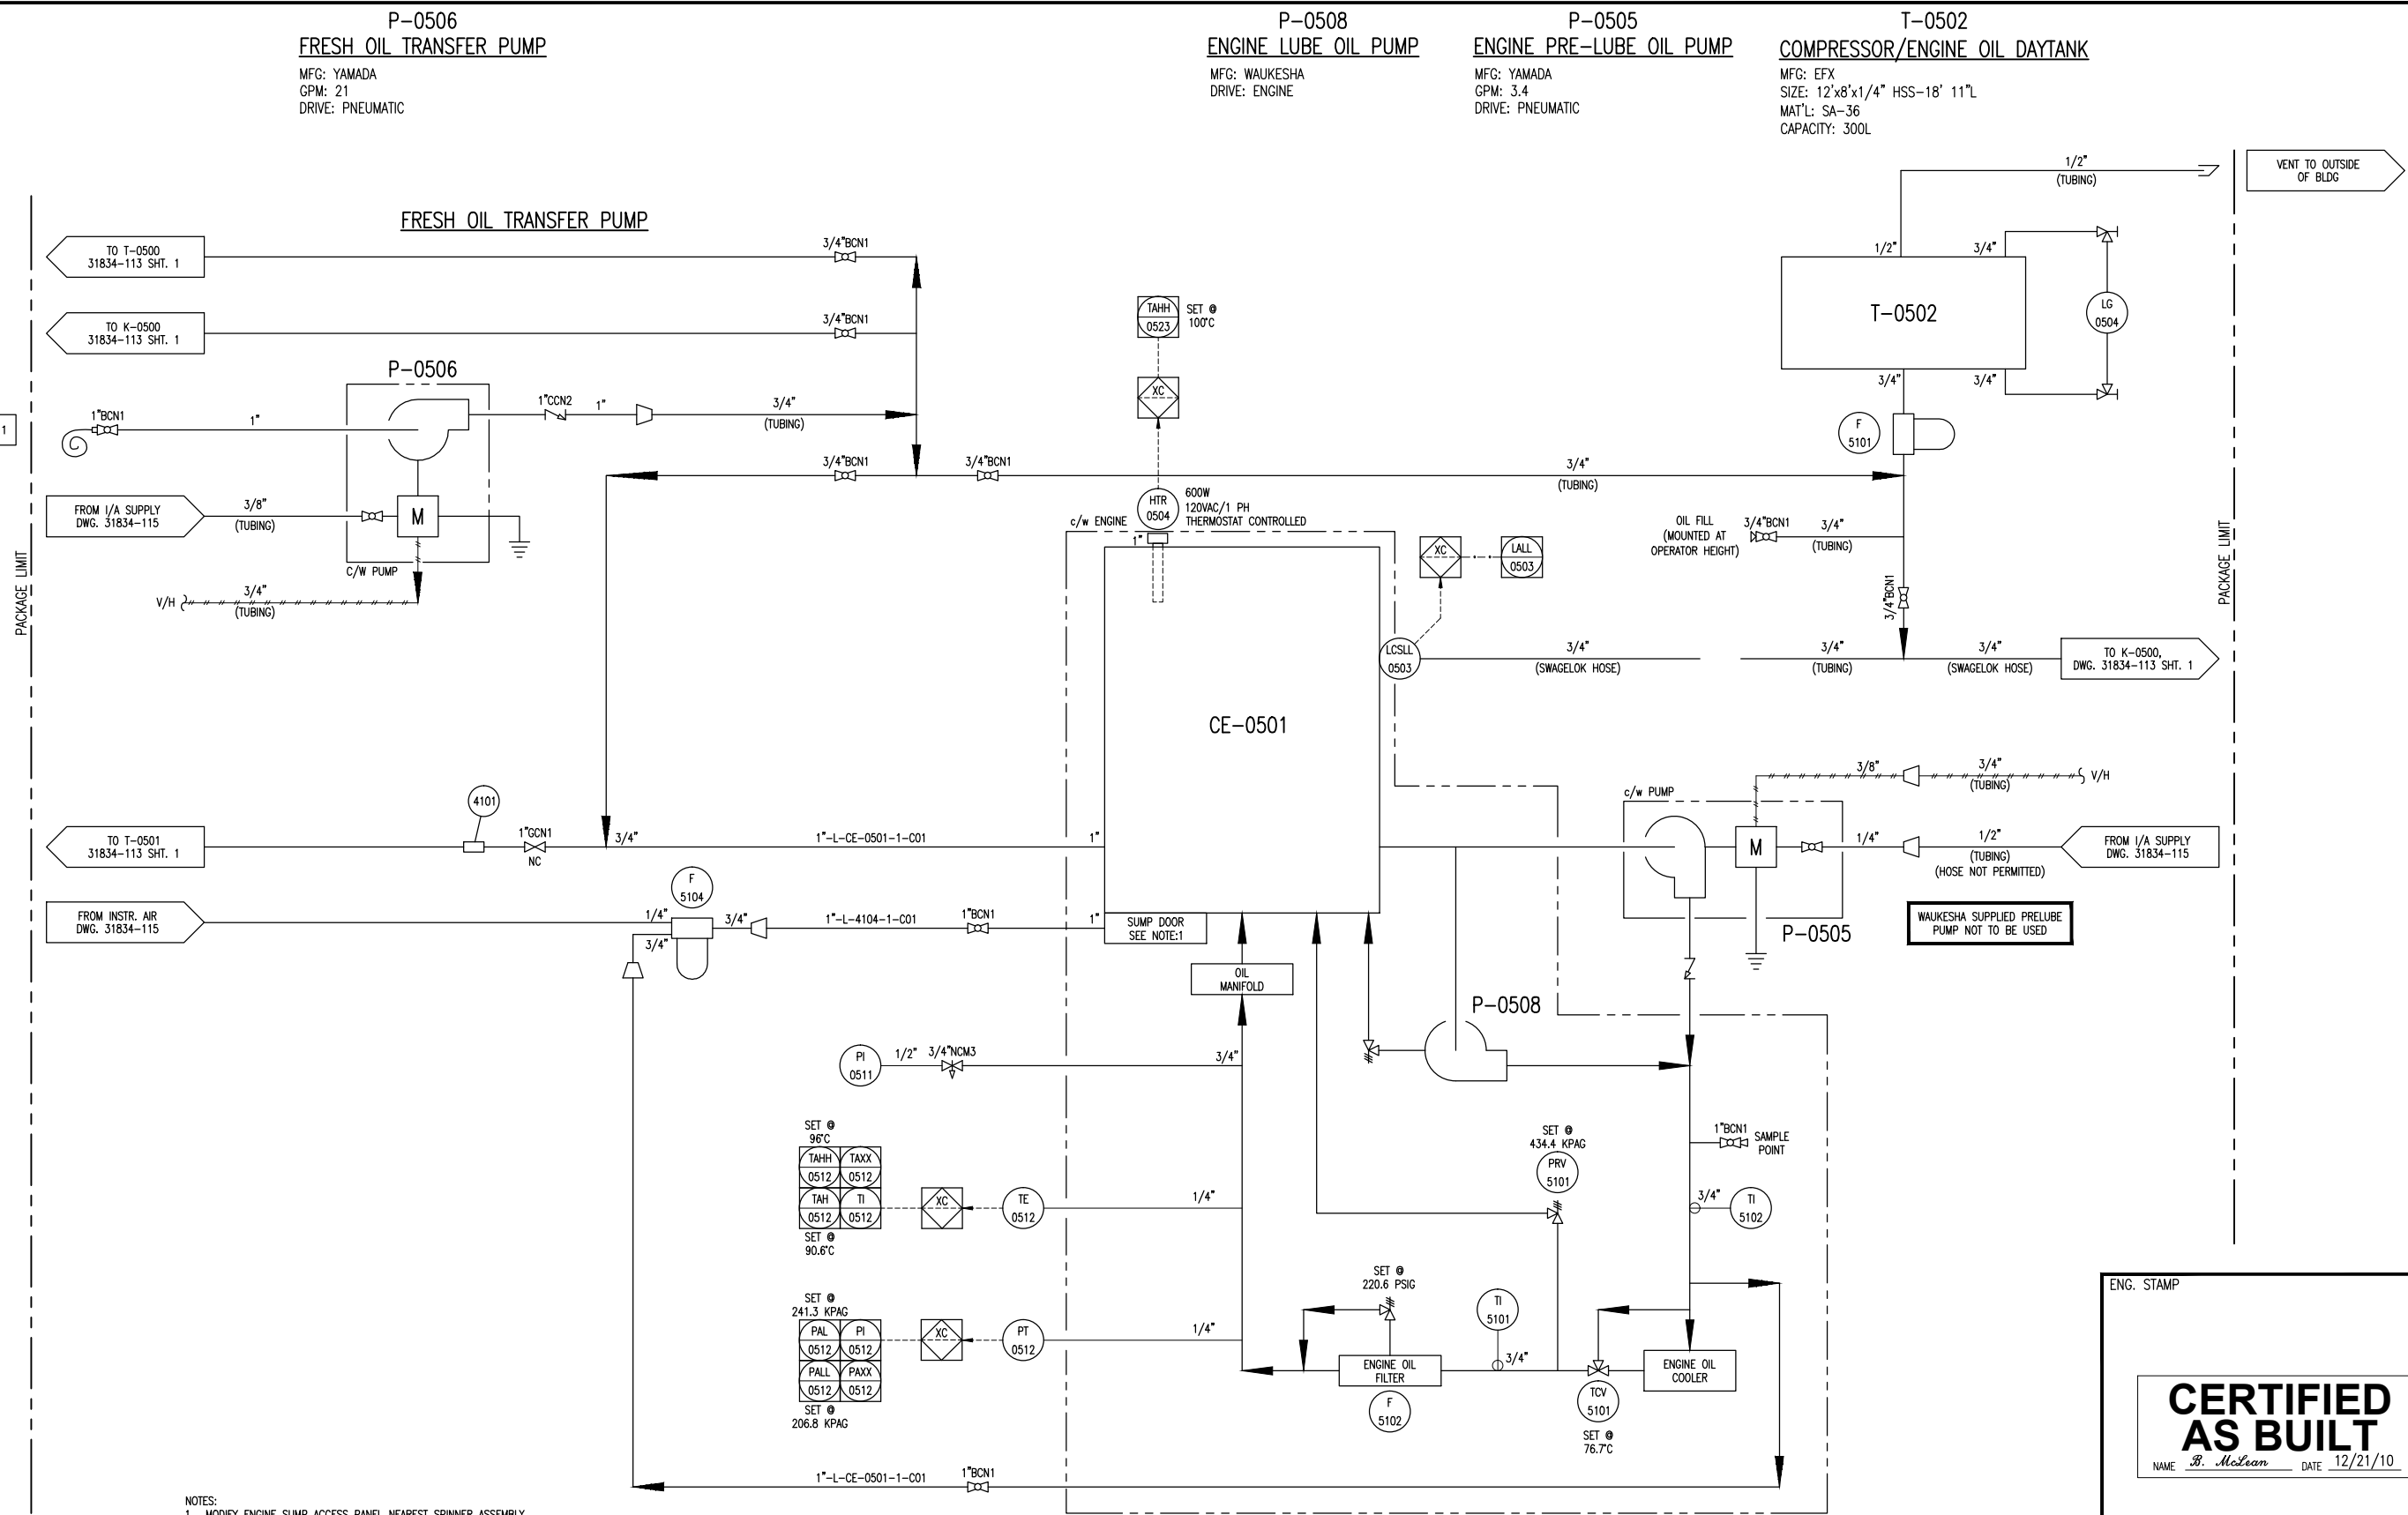

4	AS BUILT	12/21/10	JH	KG	DATE	06/04/10	SCALE	NTS
3	FOR REGISTRATION	11/22/10	JH	KG	DRAWN BY	C. EASZYHOPE	CHECKED BY	X. BROWN
2	REVISED AS PER CUSTOMER MARK UP	09/16/10	JH	KG	APPROVED BY			B. CAMPBELL
1	ISSUED FOR FABRICATION	06/25/10	BM	DC	CUST PO	N/A		
A	ISSUED FOR APPROVAL	06/04/10	CE	DC	STEP CODE	198 511 591		
REV	DESCRIPTION	DATE	BY	APR				

PERMIT TO PRACTISE	APEGGA PERMIT: No. P8651
FOR HUSKY OIL OPERATIONS LTD.	WAUKESHA F18GL
ARIEL JGJ/2-1/2 STD	


ENERFLEX
10121 - BARLOW TRAIL N.E.
CALGARY ALBERTA CANADA

DWG NO	31834-114	SHT	1	REV	4
--------	-----------	-----	---	-----	---

ENG. STAMP
CERTIFIED AS BUILT
NAME *B. McLean* DATE *12/21/10*

TITLE
P & I DIAGRAM
ENGINE LUBE OIL

PLDT DATE January 07, 2011 C:\Users\lmclean\TES\update\local\temp\KCPublish\1860\31834-111-ASBUILT.dwg

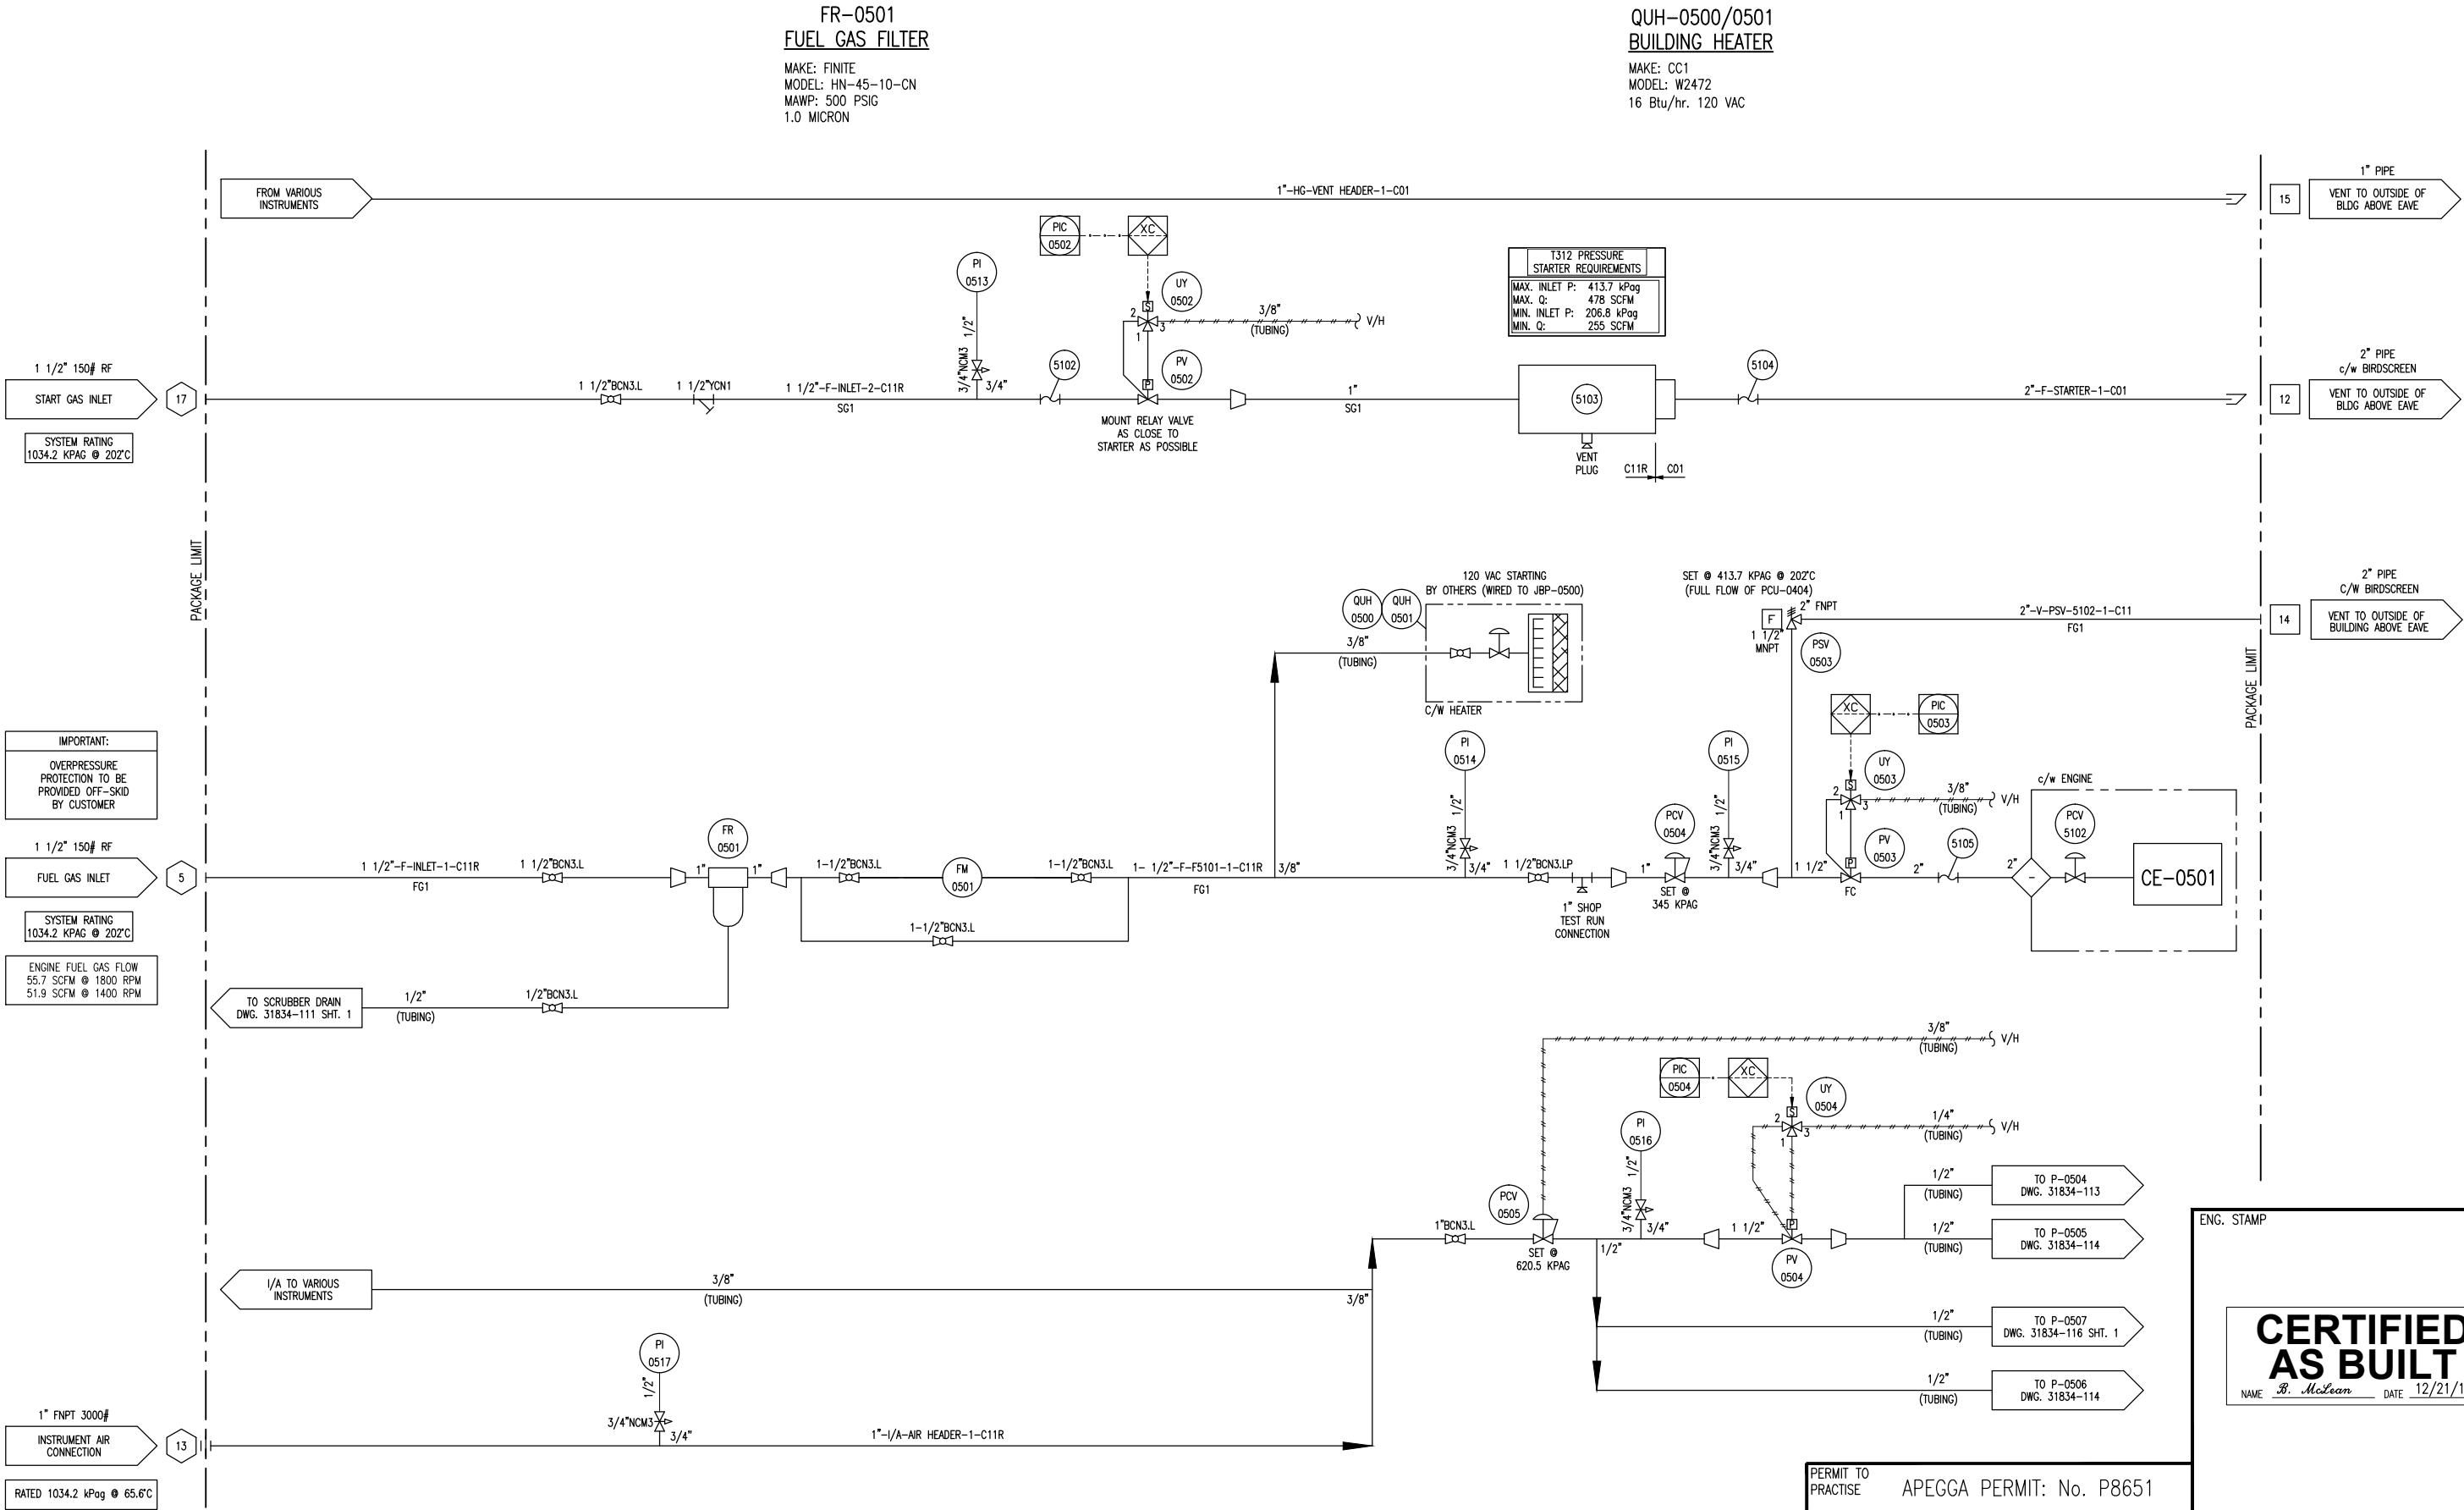

IMPORTANT:
OVERPRESSURE
PROTECTION TO BE
PROVIDED OFF-SKID
BY CUSTOMER

1 1/2" 150# RF
FUEL GAS INLET

SYSTEM RATING
1034.2 KPAG @ 202°C

ENGINE FUEL GAS FLOW
55.7 SCFM @ 1800 RPM
51.9 SCFM @ 1400 RPM

1" FNPT 3000#
INSTRUMENT AIR
CONNECTION

RATED 1034.2 kPag @ 65.6°C

3	AS BUILT	12/21/10	JH	KG	DATE	06/04/10	SCALE	NTS	FOR	HUSKY OIL OPERATIONS LTD.	ENERFLEX	TITLE	P & I DIAGRAM
2	FOR REGISTRATION	11/22/10	JH	KG	DRAWN BY	C. EASTWODE	CHECKED BY	S. BEECH	APPROVED BY	J. CAMPBELL	10121 - BARLOW TRAIL N.E. CALGARY ALBERTA CANADA	START / FUEL GAS SUPPLY	
1	ISSUED FOR FABRICATION	06/25/10	BM	DC	CUST PO	N/A							
A	ISSUED FOR APPROVAL	06/04/10	CE	DC	STEP CODE	198	511	591					
REV	DESCRIPTION	DATE	BY	APR									

PERMIT TO PRACTISE	APEGGA PERMIT: No. P8651
DATE	06/04/10
SCALE	NTS
FOR	HUSKY OIL OPERATIONS LTD.
	WAUKESHA F18GL
	ARIEL JGJ/2-1/2 STD
DWG NO	31834-115
SHT	1
REV	3

ENG. STAMP

**CERTIFIED
AS BUILT**

NAME B. McLean DATE 12/21/10

THE INFORMATION CONTAINED HEREIN IS THE CONFIDENTIAL PROPERTY OF TORMONT ENERGY SYSTEMS AND IS NOT FOR PUBLICATION, AND NO PART THEREOF SHALL BE COPIED OR COMMUNICATED TO A THIRD PARTY WITHOUT AUTHORIZATION FROM TORMONT ENERGY SYSTEMS.

C:\Users\lmclean\TES\appdata\local\Temp\AcPublish_1860\31834-111-ASBUILT.dwg
PLOT DATE January 07, 2011


T-0503
WASTE GLYCOL TANK
MFG: EFX
SIZE: 12'x8'x1/4" HSS-19'-11"L
MAT'L: SA-36
CAPACITY: 330L

P-0507
GLYCOL TRANSFER PUMP
MFG: YAMADA
GPM: 49
DRIVE: PNEUMATIC

P-0502
ENGINE JACKET
WATER PUMP
MFG: WAUKESHA
MAX. FLOW: 130 GPM
DRIVE: ENGINE

T-0504
GLYCOL (EJW) SURGE TANK
MFG: EFX
CAPACITY: 53L
SIZE: 10" TUBING x 60" LG
MAT'L: SA-36

EJW
ENGINE JACKET WATER
COOLER SECTION
MAWP: 96.5 kPag @ 149°C
NON-CODE VESSEL

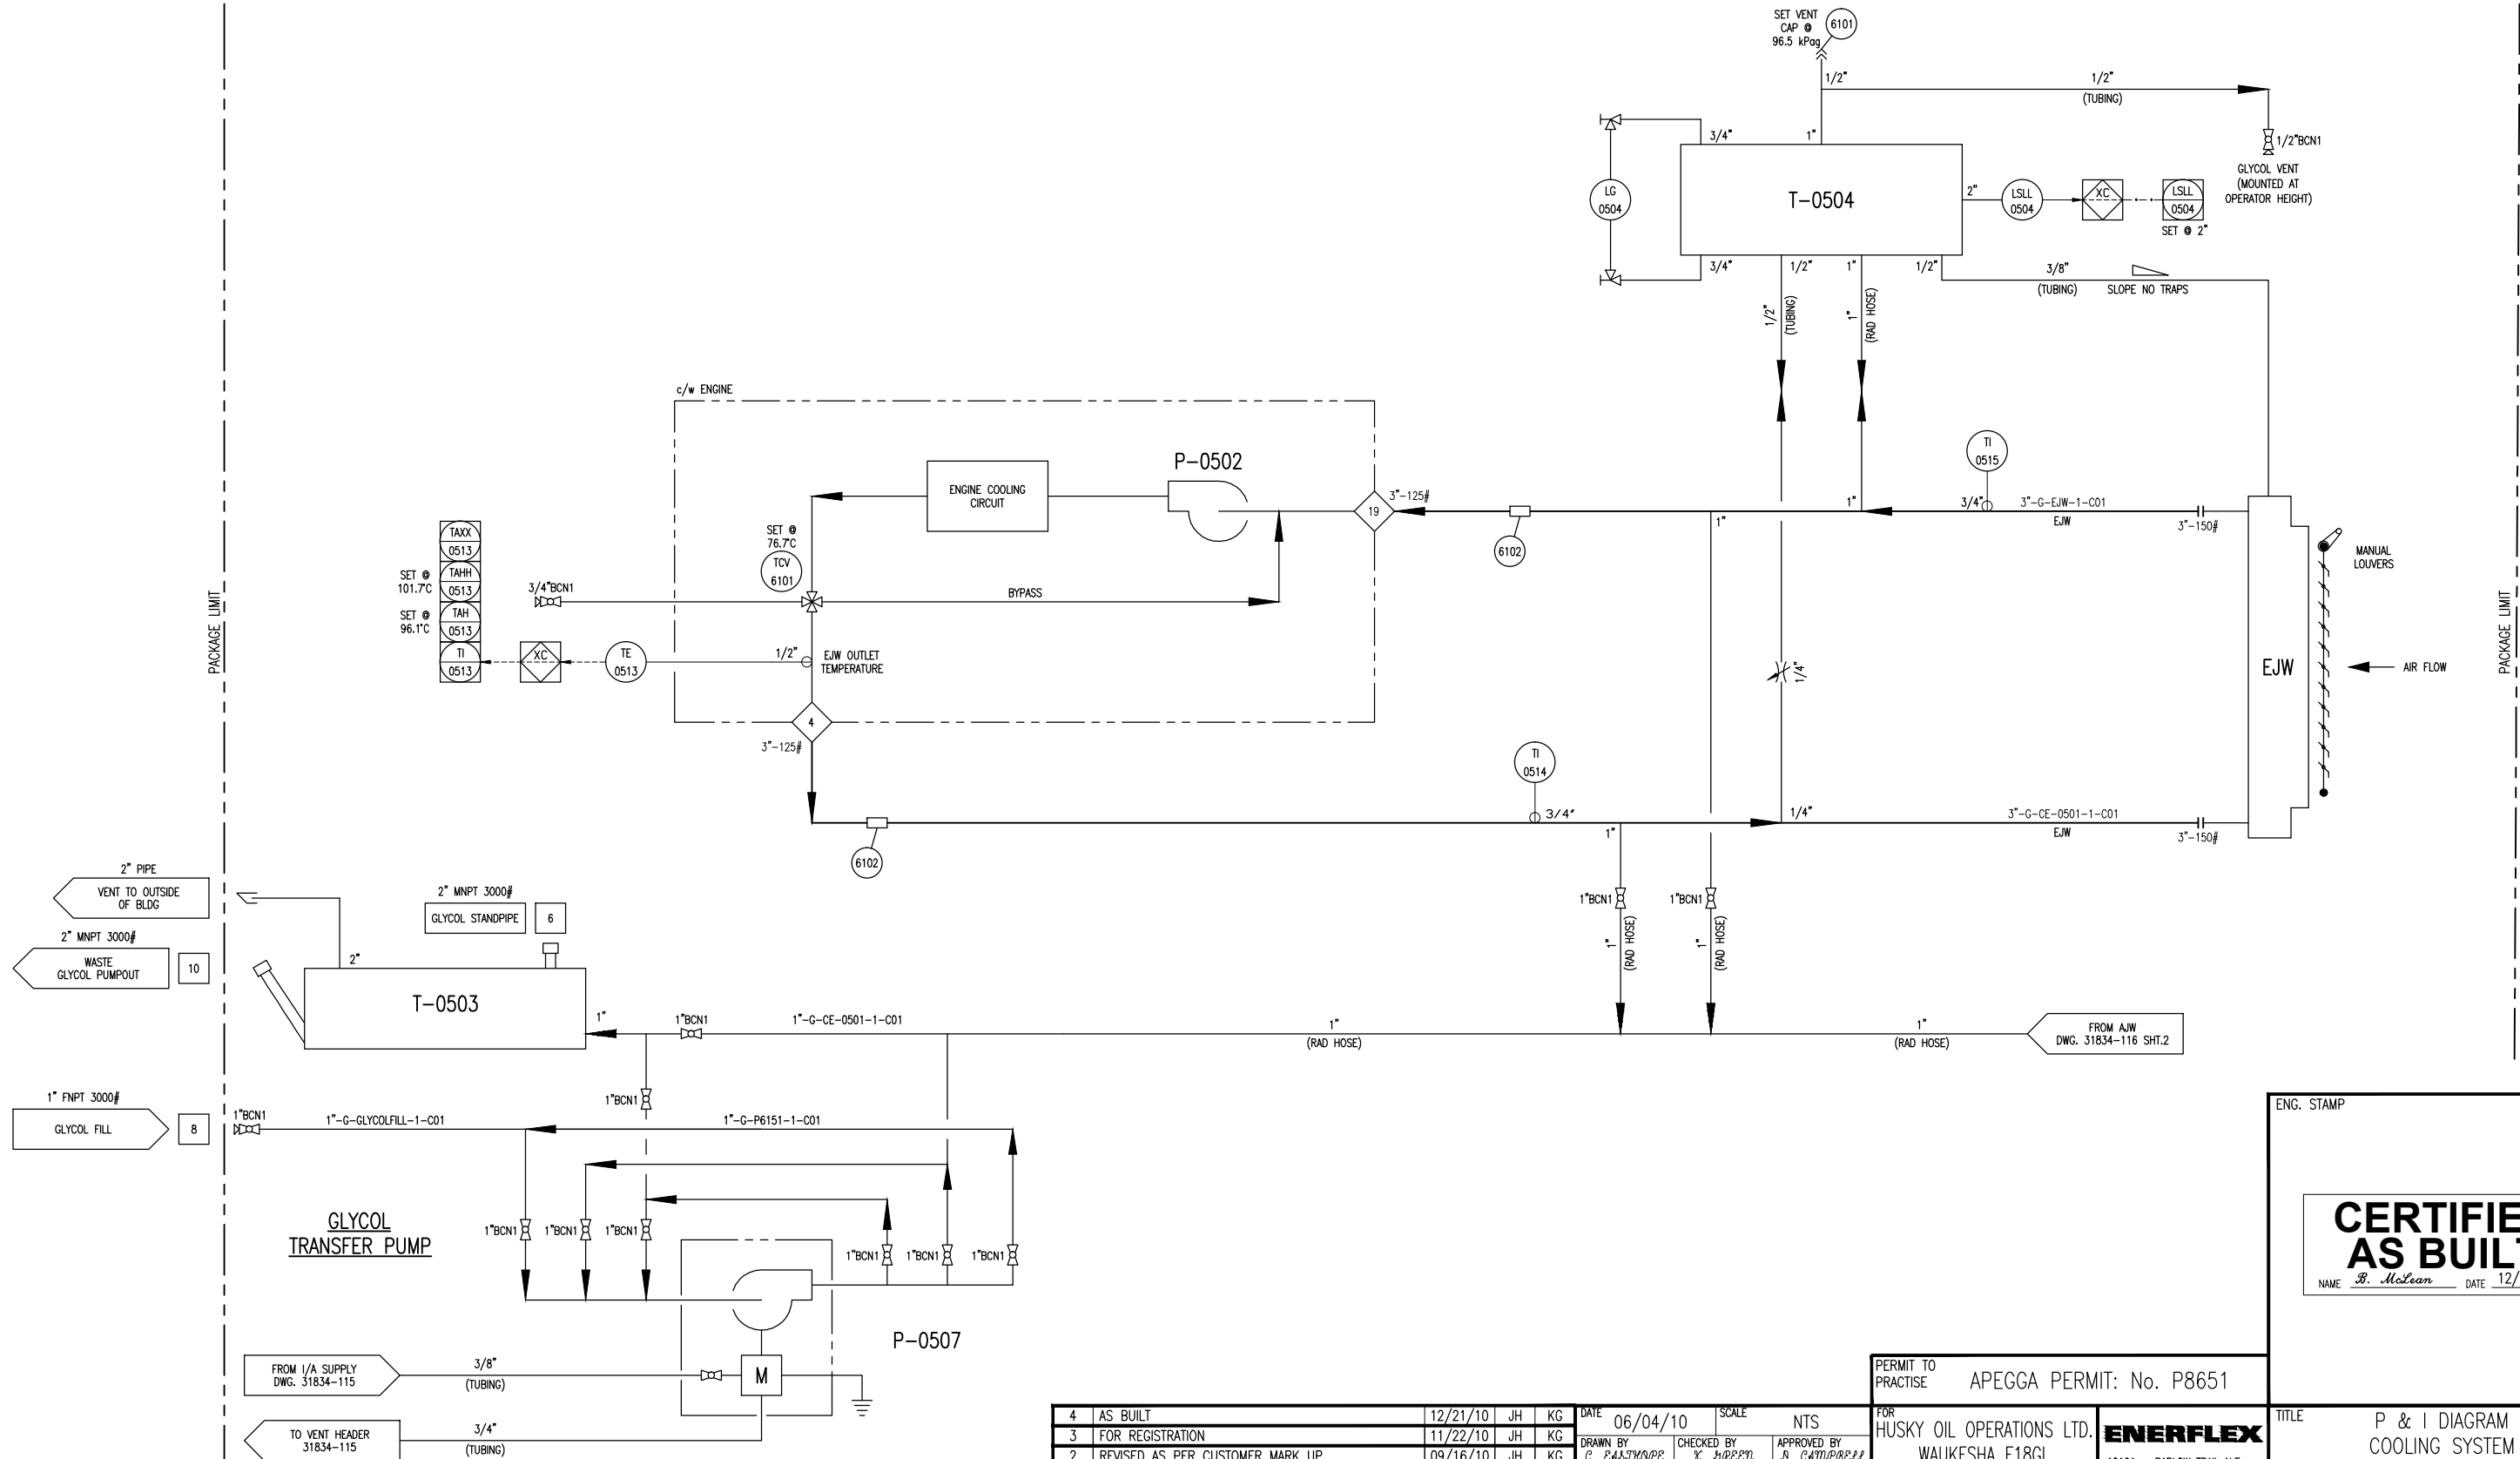

4	AS BUILT	12/21/10	JH	KG
3	FOR REGISTRATION	11/22/10	JH	KG
2	REVISED AS PER CUSTOMER MARK UP	09/16/10	JH	KG
1	ISSUED FOR FABRICATION	06/25/10	BM	DC
A	ISSUED FOR APPROVAL	06/04/10	CE	DC
REV	DESCRIPTION	DATE	BY	APR

DATE	06/04/10	SCALE	NTS
DRAWN BY	C. E. JOHNSON	CHECKED BY	X. BROWN
CUST PO	N/A	APPROVED BY	B. CAMPBELL
STEP CODE	198 511 531 591		

PERMIT TO PRACTISE	APEGGA PERMIT: No. P8651
FOR HUSKY OIL OPERATIONS LTD.	WAUKESHA F18GL
	ARIEL JGJ/2-1/2 STD

ENERFLEX	
10121 - BARLOW TRAIL N.E. CALGARY ALBERTA CANADA	
DWG NO	3183

ENG. STAMP	
<div>CERTIFIED AS BUILT</div> <div>NAME <u>B. McLean</u> DATE <u>12/21/10</u></div>	
TITLE	
P & I DIAGRAM COOLING SYSTEM ENGINE JACKET WATER	
4-116	SHT 1
	REV


THE INFORMATION CONTAINED HEREIN IS THE CONFIDENTIAL PROPERTY OF TOROMONT ENERGY SYSTEMS AND IS NOT FOR PUBLICATION, AND NO PART THEREOF SHALL BE COPIED OR COMMUNICATED TO A THIRD PARTY WITHOUT AUTHORIZATION FROM TOROMONT ENERGY SYSTEMS.

MFG: ARIEL
MODEL: B-1962
DWG #: A-4154

MFG: WAUKESHA
MAX. FLOW: 35 GPM
DRIVE: ENGINE

MFG: EFX
CAPACITY: 27L
SIZE: 10" TUBING x 60" LG
MAT'L: SA-36

MAWP: 96.5 KPAG @ 149°C
NON-CODE VESSEL

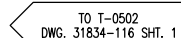PERMIT TO
PRACTISE APEGGA PERMIT: No. P8651

FOR
HUSKY OIL OPERATIONS LTD.
WAUKESHA F18GL
ARIEL JGJ/2-1/2 STD

10121 - BARLOW TRAIL N.E.
CALGARY ALBERTA CANADA

DWG NO	31834-116
-----------	-----------

TITLE	P & I DIAGRAM COOLING SYSTEM AUXILIARY JACKET WATER
-------	---

SHT	2
-----	---


REV 4

ENG. STAMP

CERTIFIED AS BUILT


NAME B. McLean DATE 12/21/10

PACKAGE LIMIT

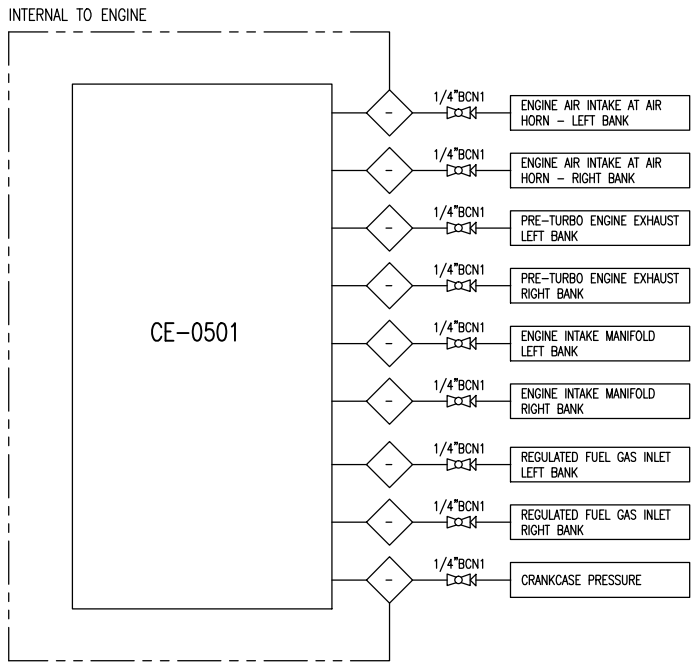


FR-0502
AIR FILTER
MFG: WAUKESHA
QTY: 1

7101
EXHAUST SILENCER
MFG: SILEX
MODEL: JDDS-8

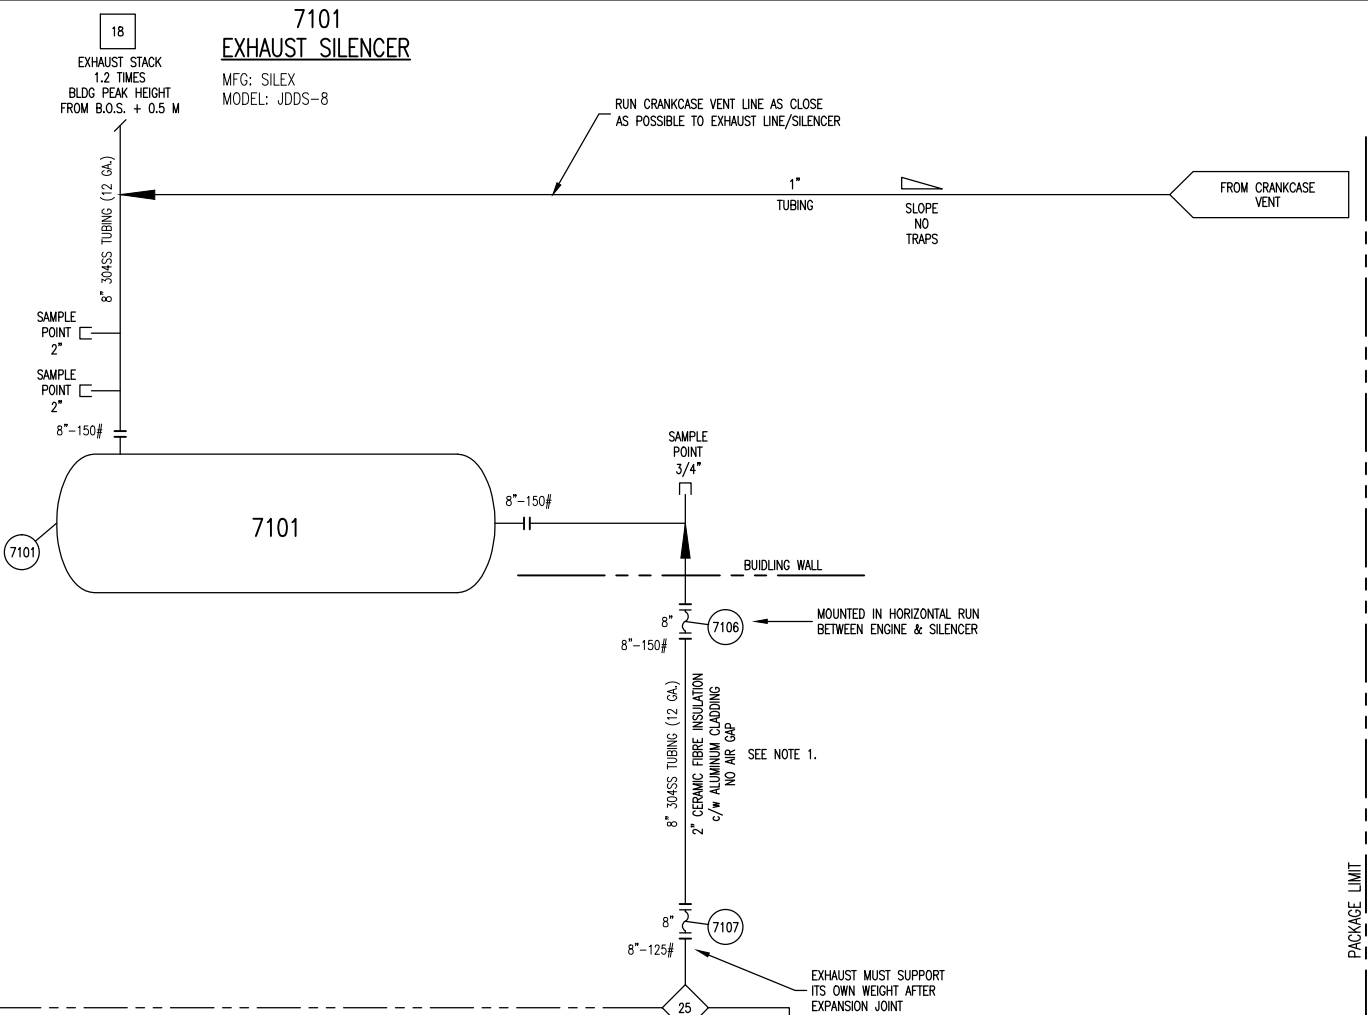

PACKAGE LIMIT

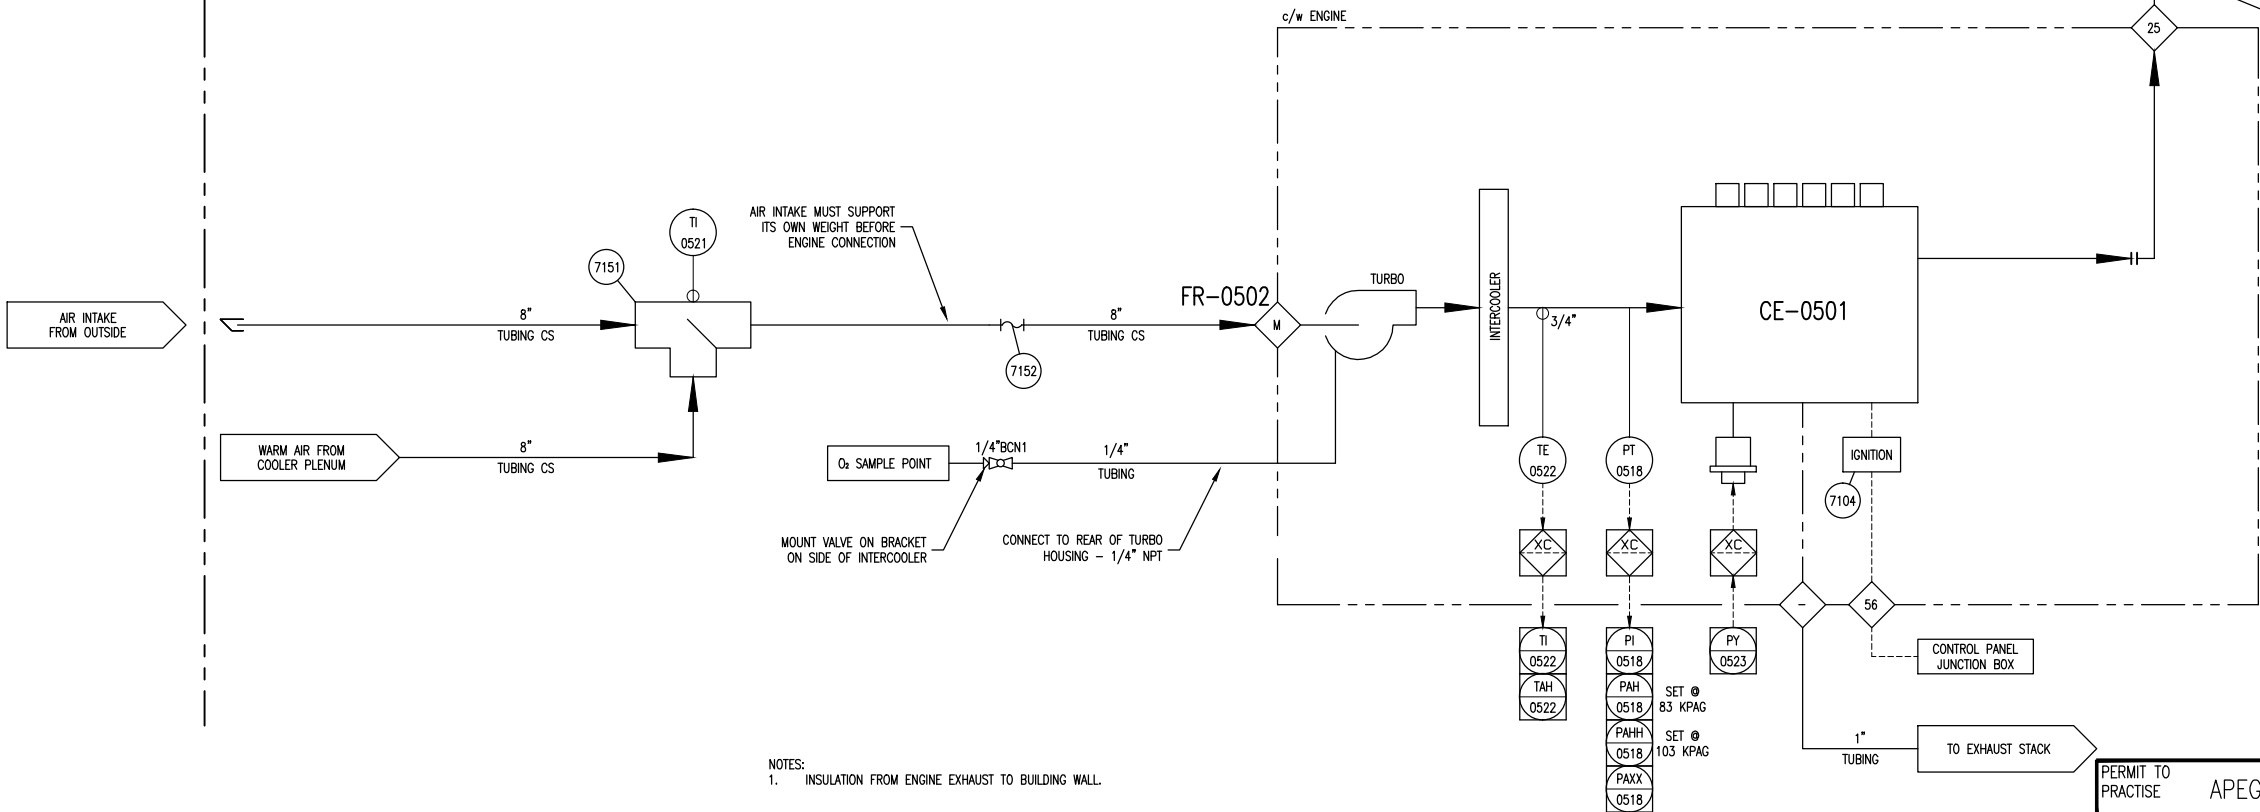

ENG. STAMP

CERTIFIED AS BUILT
NAME B. McLean DATE 12/21/10

PERMIT TO PRACTISE APEGGA PERMIT: No. P8651

FOR HUSKY OIL OPERATIONS LTD.
WAUKESHA F18GL
ARIEL JG1/2-1/2 STD

ENERFLEX

10121 - BARLOW TRAIL N.E.
CALGARY ALBERTA CANADA

TITLE P & I DIAGRAM
AIR / EXHAUST SYSTEMS


DWG NO 31834-117

SHT 1

REV 4

4	AS BUILT	12/21/10	JH	KG	DATE	06/04/10	SCALE	NTS
3	FOR REGISTRATION	11/22/10	JH	KG	DRAWN BY	C. EAGAN	CHECKED BY	X. BROWN
2	REVISED AS PER CUSTOMER MARK UP	09/16/10	JH	KG	APPROVED BY	D. CAMPBELL		
1	ISSUED FOR FABRICATION	06/25/10	BM	DC	CUST PO	N/A		
A	ISSUED FOR APPROVAL	06/04/10	CE	DC	STEP CODE	198 511 531 591		
REV	DESCRIPTION	DATE	BY	APR				

P:\30000 Projects\31834 Husky R400 F188L J027\31834-MODEL-0.dwg
PLOT DATE July 08, 2010

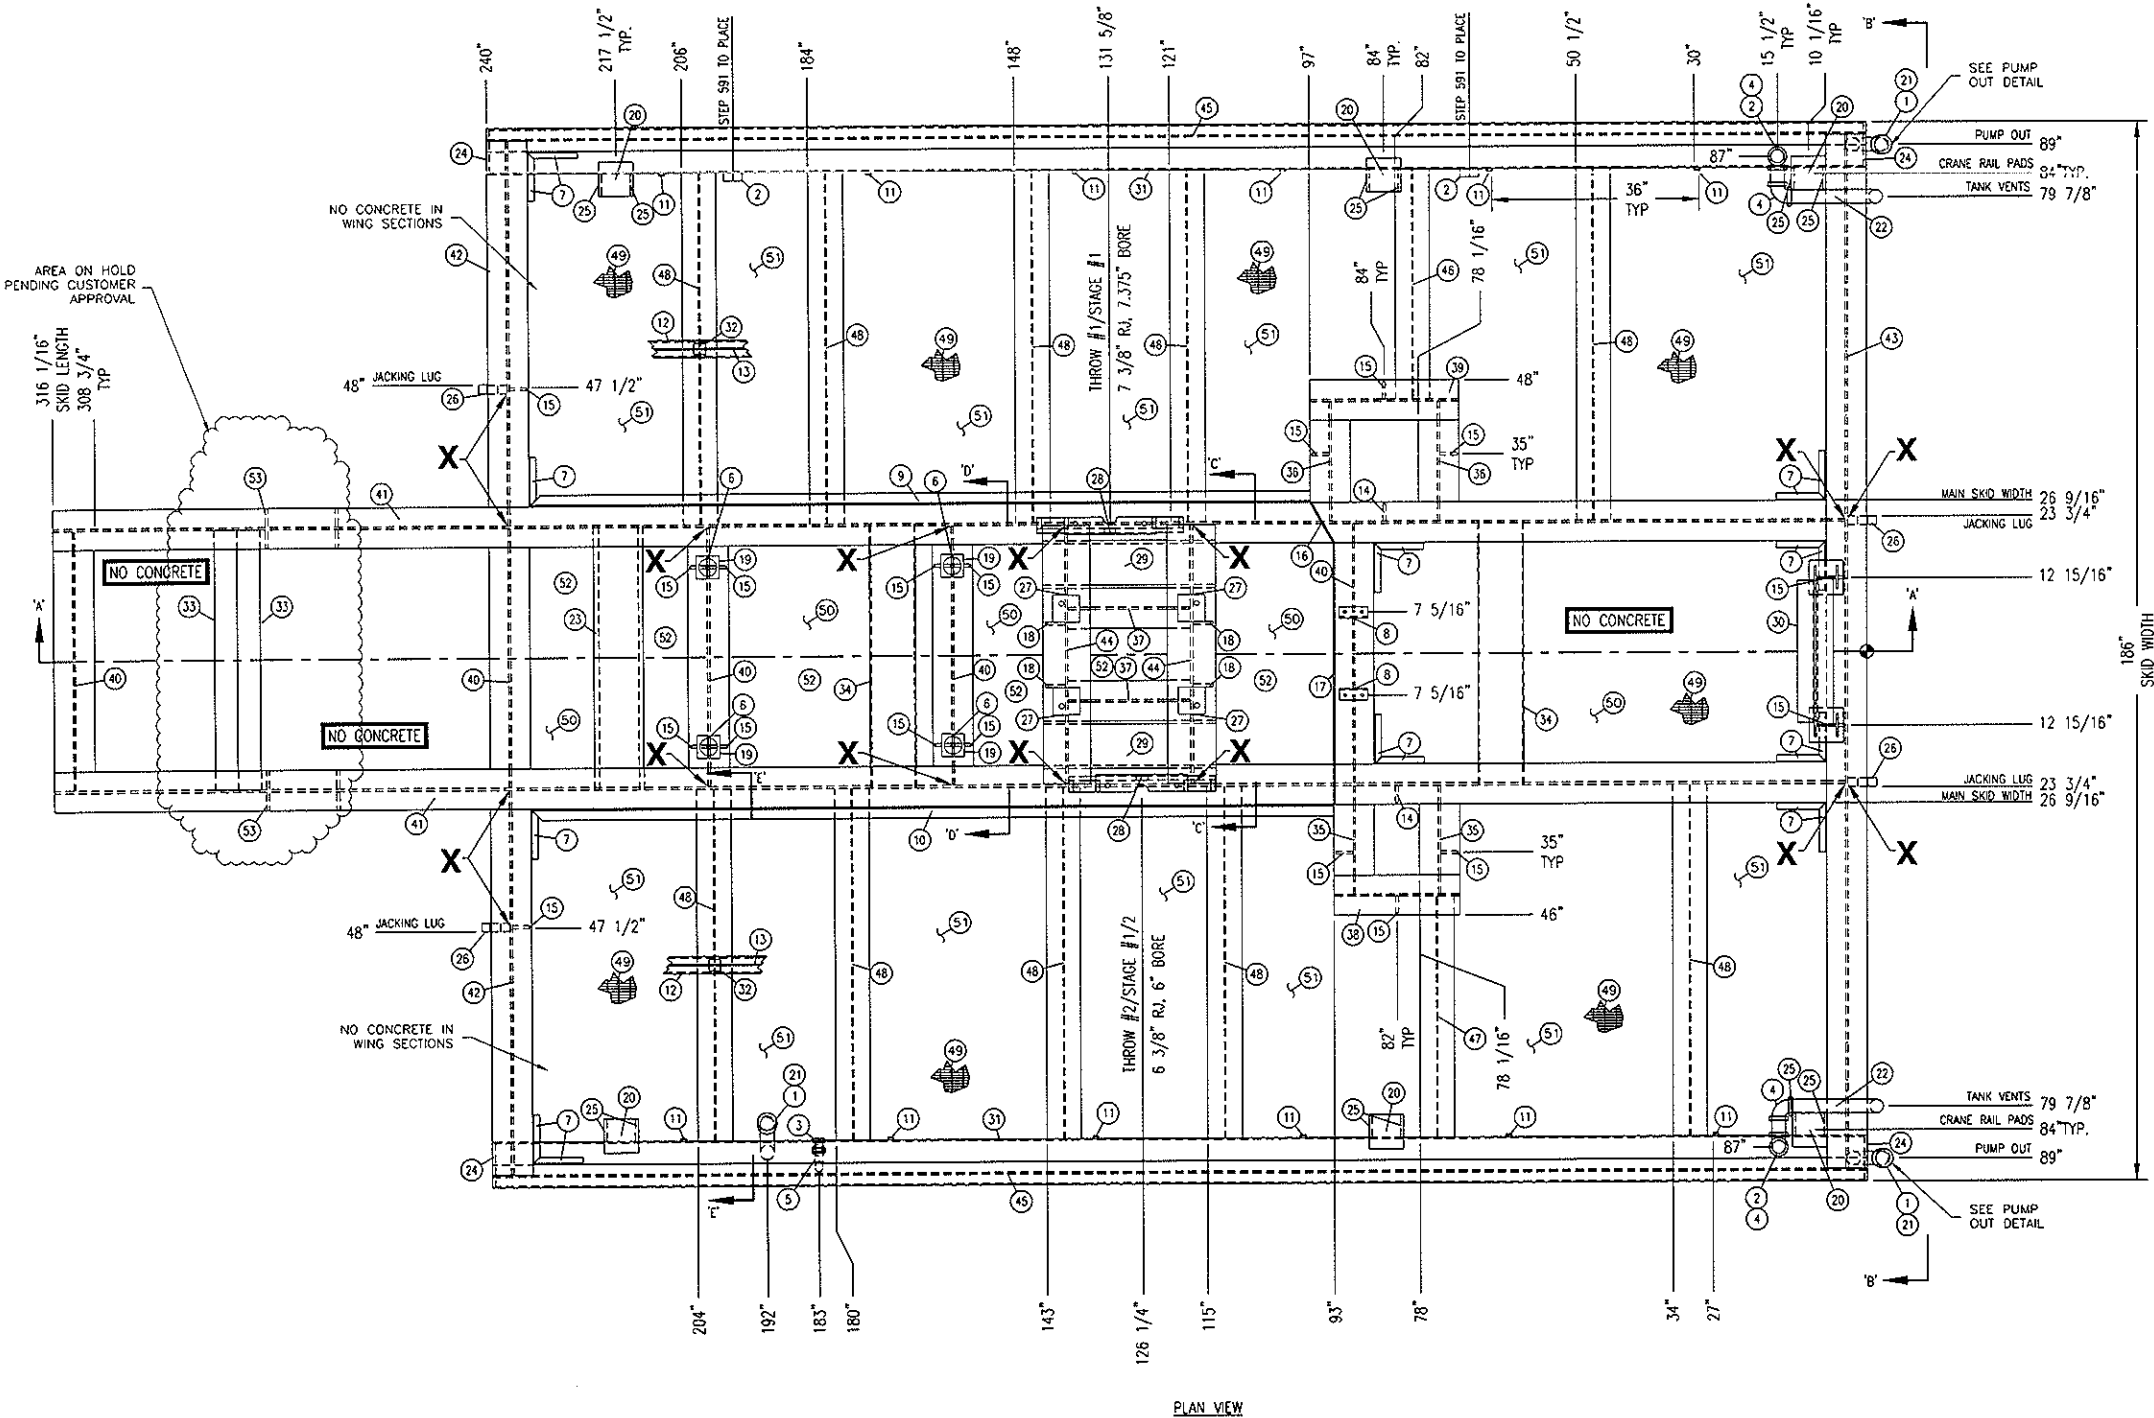

PLAN VIEW

IMPORTANT NOTICE TO OWNER/OPERATOR

THE DESIGN OF THE FOUNDATION FOR THIS COMPRESSOR PACKAGE IS NOT IN THE SCOPE OF SUPPLY BY TOROMONT ENERGY SYSTEMS INC. ("TES"). AS SUCH, THE DESIGN AND ADEQUACY OF THE FOUNDATION IS ENTIRELY THE RESPONSIBILITY OF THE OWNER/OPERATOR AND/OR ITS ENGINEERING FIRM AND THEIR REPRESENTATIVES. REFER TO TESI DWG. NO. 31834-351, SHEET 1 FOR FURTHER INFORMATION, AND OWNER/OPERATOR'S OBLIGATIONS AND LEGAL LIMITATIONS.

NOTES

1. GRIND ALL ROUGH EDGES & WELD SPATTER.
2. SANDBLAST INTERIORS OF CYCLO STORAGE TANK PRIOR TO FINAL ASSEMBLY.
3. AIR PRESSURE TEST CYCLO & OIL TANKS TO 10 PSI.
4. CONSTRUCT STRUCTURE FLUSH TO TOP UNLESS OTHERWISE NOTED.
5. ALL TAIL DIMENSIONS FROM REFERENCE POINT.
6. WEIGHT OF SKID (w/o CONCRETE) 10,500 lbs.
7. 1/4" IN LENGTH HAS BEEN REMOVED FROM ITEMS #40 & 44 FOR FIT UP.
8. SEAL PAN IS FLAT.
9. PRIMER- TFS-SP-001, FIN-1, RED OXIDE
PAINT- TFS-SP-001, FIN-1, 20-F "WARM GREY"
10. ALL WELDS TO BE 1/4" MIN. FILLETS ALL AROUND, UNLESS OTHERWISE NOTED.
11. FULL PENETRATION WELD REQUIRED AT THESE LOCATIONS.
12. X FULL STRENGTH WELD REQUIRED AT THESE LOCATIONS.

REV	DESCRIPTION	DATE	BY	APR
2	REV. FOR CWS WELDING PROCEDURES.	07/08/10	BM	CK
1	ISSUED FOR CONSTRUCTION	06/30/10	BM	CK
A	ISSUED FOR APPROVAL	06/18/10	BM	CK

DATE	06/18/10	SCALE	3/4"=1'-0"	FOR	HUSKY OIL OPERATIONS LTD.
DRAWN BY	B. McLean	CHECKED BY	C. Jam	APPROVED BY	B. Campbell
CUST PO	N/A				
STEP CODE	400				

DESTROY PREVIOUS COPIES

ENERFLEX
10121 - BARLOW TRAIL N.E.
CALGARY ALBERTA CANADA

DWG NO 31834-301


PERMIT TO PRACTISE APEGGA PERMIT: No. P8651

TITLE
STRUCTURAL STEEL

SHT 1 REV 2

BILL OF MATERIAL

QTY	DESCRIPTION	MAT.	LENGTH	PART NUMBER
1	CAP, 2" 3000# NPT	SA-105	-	115-HRB-0200
2	COUPLING, 2" 3000# NPT, HALF	SA-105	-	123-HRB-0200
3	ELBOW, 1" 3000# 450 NPT	SA-105	-	142-HRB-0100
4	ELBOW, 2" 3000# 500 NPT	SA-105	-	146-HRB-0200
5	PIPE, 1" XS SMLS, 106VPOE (OUT TO SMT)	SA-106-B	4	600-NPA-0100
6	VIBRACON SM16 ADJUSTABLE CHECK	-	-	NPN
7	ANGLE, 1-1/4" X 1-1/4" 3/16" THK	G40.2144W	900	005-HA-0125-0125-0018
8	ANGLE, 2" X 2-1/4" THK	G40.2144W	5	005-HA-0200-0200-0025
9	ANGLE, 2" X 2-1/4" THK	G40.2144W	135 15/16	005-HA-0200-0200-0025
10	ANGLE, 2" X 2-1/4" THK	G40.2144W	139 15/16	005-HA-0200-0200-0025
11	CHANNEL, 1" X 0.83	G40.2144W	8	018-HA-0100-0008
12	CHANNEL, 3" X 4.1	G40.2144W	225 7/8	018-HA-0300-0041
13	FLAT BAR, 1" X 1/4" THK	G40.2144W	225 7/8	010-HA-0100-0025
14	FLAT BAR, 3" X 1/2" THK	G40.2144W	4 1/2	010-HA-0300-0050
15	FLAT BAR, 3" X 1/2" THK	G40.2144W	15	010-HA-0300-0050
16	FLAT BAR, 3/4" X 1/4" THK	G40.2144W	8 1/8	010-HA-0075-0025
17	FLAT BAR, 3/4" X 1/4" THK	G40.2144W	46	010-HA-0075-0025
18	FLAT BAR, 3-1/2" X 1/2" THK	G40.2144W	19 3/4	010-HA-0350-0050
19	MOUNTING BLOCK 4" SQUARE X 2", C1018 COLD ROLLED, FLAT BAR (SEE DWG. EMB-H24-F18 REV.0)	C1018	4	NPN
20	FLAT BAR, 6" X 1/2" THK	G40.2144W	6	010-HA-0600-0050
21	PIPE, 2" S/80(XS), ERW	SA-106-B	15	602-HPB-0200
22	PIPE, 2" S/80(XS), ERW	SA-106-B	48	602-HPB-0200
23	PIPE, 8" XS SMLS	SA-106-B	46 3/8	600-PPA-0800
24	PLATE, 1/2" SMOOTH X 1" X 8"	G40.2144W	12	040-HA-0050
25	PLATE, 1/2" SMOOTH X 7 3/16" X 3 5/16" (ONE CUTS TWO)	G40.2144W	7 3/16	040-HA-0050
26	PLATE, 1-1/2" SMOOTH X 1" X 5" (SEE DWG. LIFT LUG REV.0)	G40.2144W	12	040-HA-0150
27	MOUNTING BLOCK 4 3/4" SQUARE X 2", C1018 COLD ROLLED, FLAT BAR (SEE DWG. APBL-MB-JGR/2 REV.0)	C1018	4 3/4	NPN
28	CYLINDER SUPPORT, SEE DWG. JUGI-ALL CYLINDER SUPPORT	G40.2144W	-	NPN
29	PLATE, 3/4" SMOOTH X 2'-6" X 10 3/4"	G40.2144W	30	040-HA-0075
30	PANEL STAND, 30" WIDE, SEE DWG. PANEL STAND REV.1	G40.2144W	-	NPN
31	TUBING, 12" X 1/4" THK	G40.21350W	239	020-HA-1200-0800-0025
32	TUBING, 2" X 3/16" THK	G40.21350W	9 1/8	020-HA-0200-0200-0018
33	TUBING, 4" X 1/4" THK	G40.21350W	47 1/4	020-HA-0400-0400-0025
34	TUBING, 8" X 1/4" THK	G40.21350W	46 3/8	020-HA-0800-0800-0025
35	WIDE FLANGE, 16" X 50#	G40.2150W	19 1/16	034-HA-1600-0500
36	WIDE FLANGE, 16" X 50#	G40.2150W	21 1/16	034-HA-1600-0500
37	WIDE FLANGE, 16" X 50#	G40.2150W	21 5/16	034-HA-1600-0500
38	WIDE FLANGE, 16" X 50#	G40.2150W	22	034-HA-1600-0500
39	WIDE FLANGE, 16" X 50#	G40.2150W	26	034-HA-1600-0500
40	WIDE FLANGE, 16" X 50#	G40.2150W	45 3/8	034-HA-1600-0500
41	WIDE FLANGE, 16" X 50#	G40.2150W	312 5/16	034-HA-1600-0500
42	WIDE FLANGE, 16" X 50#	G40.2150W	67 5/8	034-HA-1600-0500
43	WIDE FLANGE, 16" X 50#	G40.2150W	181 11/16	034-HA-1600-0500
44	WIDE FLANGE, 21" X 68#	G40.2150W	45 3/8	034-HA-2100-0680
45	WIDE FLANGE, 4" X 13#	G40.2150W	240	034-HA-0400-0130
46	WIDE FLANGE, 6" X 15#	G40.2150W	40 3/8	034-HA-0600-0150
47	WIDE FLANGE, 6" X 15#	G40.2150W	42 3/8	034-HA-0600-0150
48	WIDE FLANGE, 6" X 15#	G40.2150W	61 13/16	034-HA-0600-0150
49	BAR GRATING, 1" DEEP X 3/16" (SQ. FT.)	-	220	049-15W4-HAP-0018-0100
50	PLATE, 1/2" CASMOOTH SHEAR TO 3'-6" (CTS) (SHOP TO ORDER)	G40.2144W	228	044-HA-0012
51	PLATE, 1/2" CASMOOTH (CTS) (SQ. FT.) (SHOP TO ORDER)	G40.2144W	200	044-HA-0012
52	CONCRETE, MIX 20850H1, 20 MPA, STRENGTH C/W AR, 2292 KG/M CU. (142LBS/FT3) (M. CU.) (SEE SECTION A-A FOR LOCATIONS)	-	2.1	CONCRETE-20850H1-350
53	PIPE, 2" XS SMLS	SA-106-B	7 1/16	602-JPB-1200

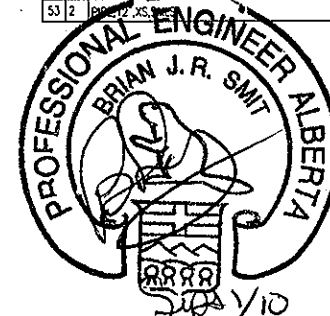


RELEASED FOR FABRICATION


NAME B. McLean DATE 07/08/10

THE INFORMATION CONTAINED HEREIN IS THE CONFIDENTIAL PROPERTY OF TOROMONT ENERGY SYSTEMS AND IS NOT FOR PUBLICATION, AND NO PART THEREOF SHALL BE COPIED OR COMMUNICATED TO A THIRD PARTY WITHOUT AUTHORIZATION FROM TOROMONT ENERGY SYSTEMS.


P:\30000 Projects\31834 Husky R400 F18CL AC2\31834-MODEL-0.dwg
PLOT DATE: July 08, 2010

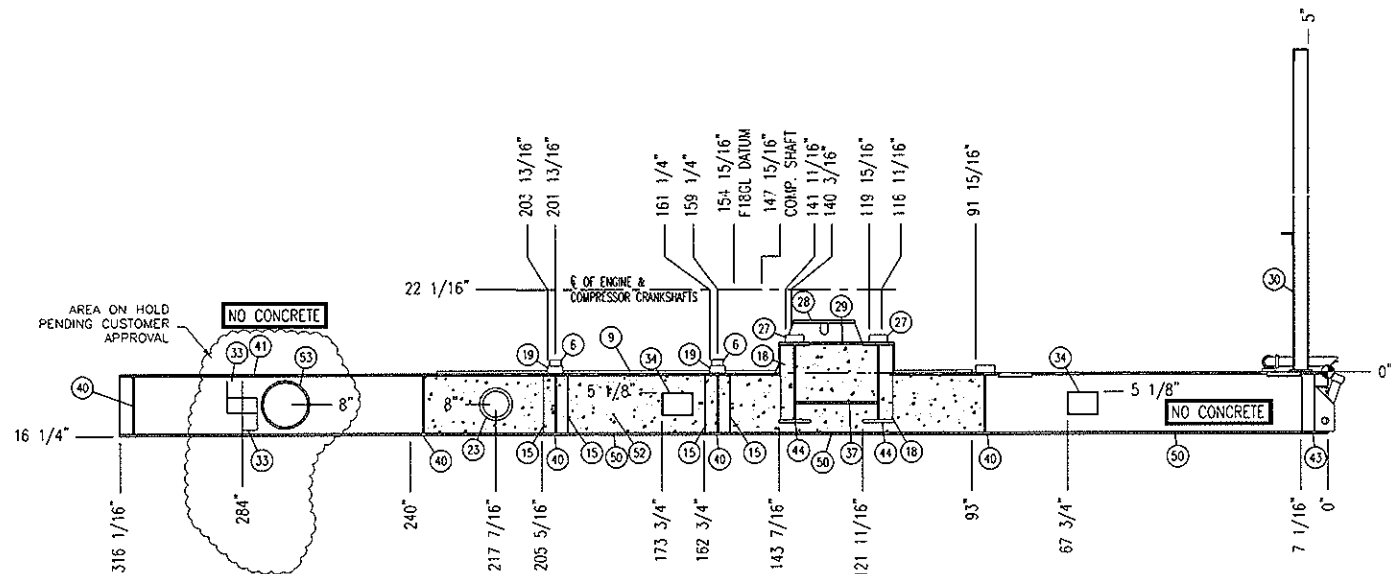


ELEVATION VIEW A-A
SCALE: 1/2"=1'-0"

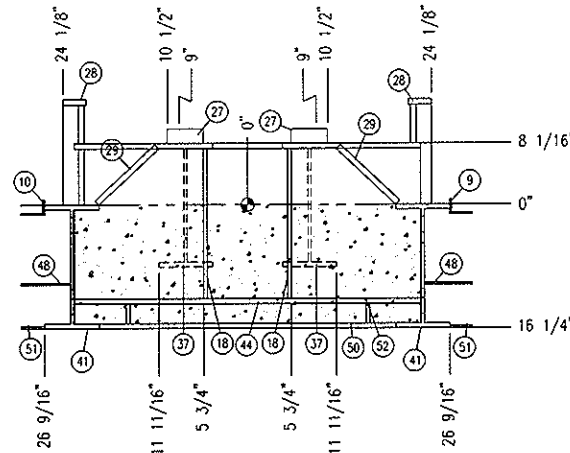


SECTION VIEW C-C
SCALE: 1"=1'-0"

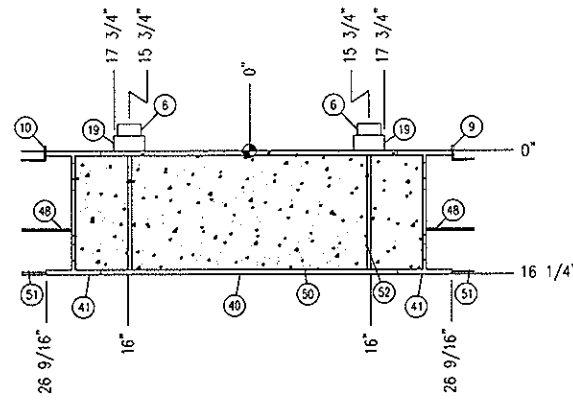


SECTION VIEW D-D
SCALE: 1"=1'-0"

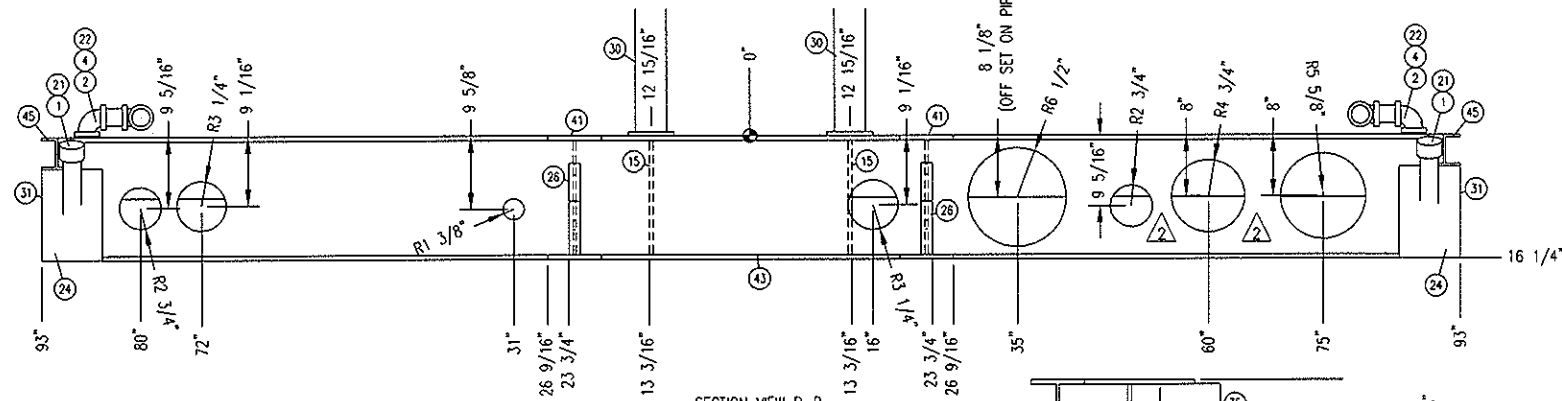


SECTION VIEW B-B
SCALE: 1"=1'-0"

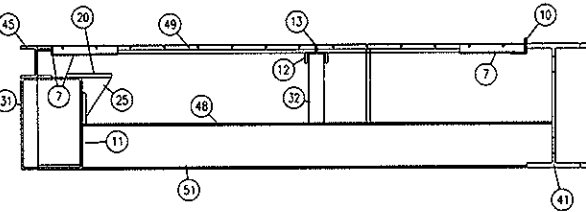


SECTION VIEW E-E
SCALE: 1"=1'-0"

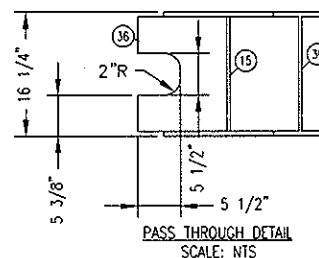


PASS THROUGH DETAIL
SCALE: NTS

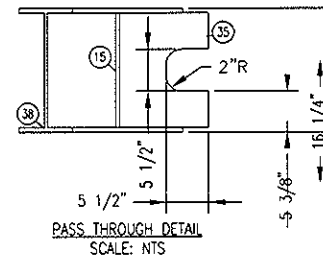


PASS THROUGH DETAIL
SCALE: NTS

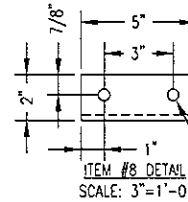


ITEM #8 DETAIL
SCALE: 3"=1'-0"

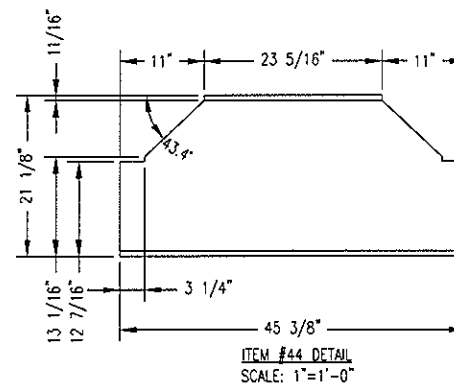


ITEM #44 DETAIL
SCALE: 1"=1'-0"

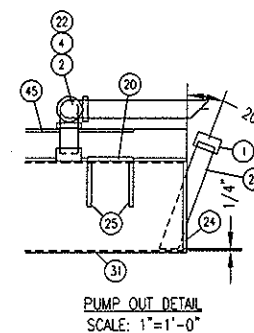


PUMP OUT DETAIL
SCALE: 1"=1'-0"

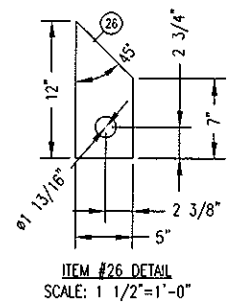

ITEM #26 DETAIL
SCALE: 1 1/2"=1'-0"

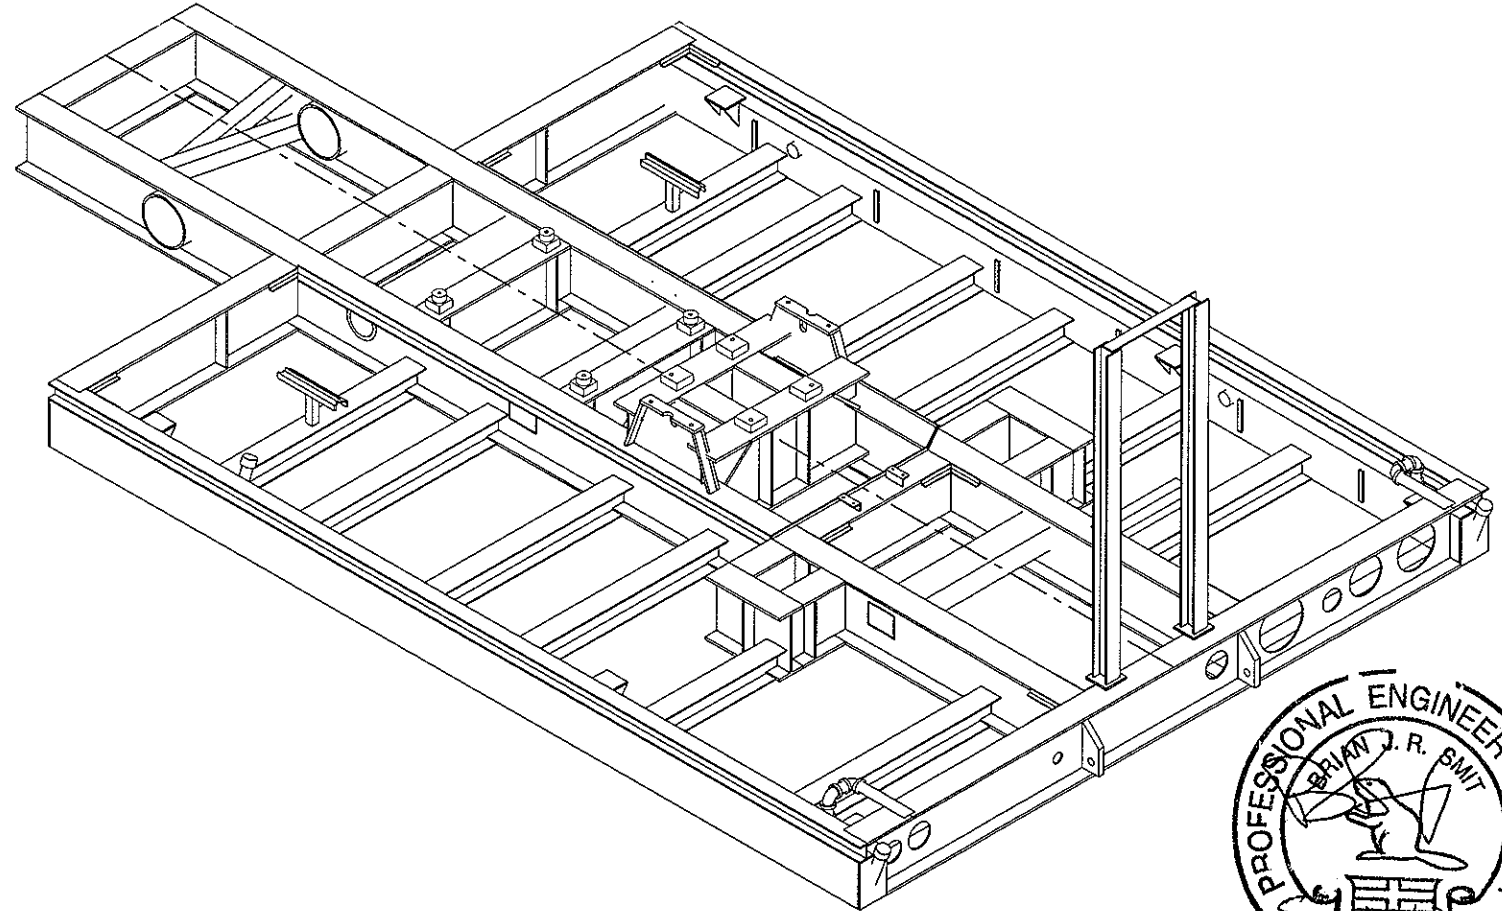

3D SKID ELEVATION
SCALE: NTS

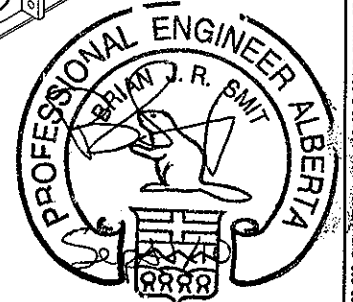

RELEASED FOR
FABRICATION
NAME: B. McLean DATE: 07/07/10

DESTROY PREVIOUS COPIES

REV	DESCRIPTION	DATE	BY	APR
2	REV. VIEW B-B	07/07/10	BM	CK
1	ISSUED FOR CONSTRUCTION	06/30/10	BM	CK
A	ISSUED FOR APPROVAL	06/18/10	BM	CK

DATE	06/18/10	SCALE	AS SHOWN
DRAWN BY	B. McLean	CHECKED BY	C. Xam
CUST PO	N/A	APPROVED BY	B. Campbell
STEP CODE	400		

FOR
HUSKY OIL OPERATIONS LTD.
WAUKESHA F18CL
ARIEL JGJ/2-1/2 STD

ENERFLEX
10121 - BARLOW TRAIL N.E.
CALGARY ALBERTA CANADA

PERMIT TO PRACTISE	APEGGA PERMIT: No. P8651	TITLE	STRUCTURAL STEEL DETAILS & SECTIONS
DWG NO	31834-301	SHT	2
		REV	2

THE INFORMATION CONTAINED HEREIN IS THE CONFIDENTIAL PROPERTY OF TOROMONT ENERGY SYSTEMS AND IS NOT FOR PUBLICATION AND NO PART THEREOF SHALL BE COPIED OR COMMUNICATED TO A THIRD PARTY WITHOUT AUTHORIZATION FROM TOROMONT ENERGY SYSTEMS.

- NOTES:
- EXTERIOR WALLS TO BE: 22GA TAN QC8315
 - EXTERIOR ROOF TO BE: 22GA TAN QC8315
 - EXTERIOR TRIM TO BE: 22GA METRO BROWN QC8228
 - DOORS TO BE PAINTED: METRO BROWN QC8228
 - INTERIOR LINER TO BE: 20GA 10% PERFORATED WHITE ALUM. OVER 3', 24GA WHITE ALUM BELOW
 - INSULATION IN WALLS: R-12 FIBERGLASS BATT
 - INSULATION IN ROOF: R-20 FIBERGLASS BATT
 - VAPOUR BARRIER TO BE: 6 MIL

SURFACE AREA =	1219 SQR/FT.
APROX. TOTAL SHIPPING WEIGHT =	5200lbs. BUILDING ONLY

- 2 - 18" x 32" MANUALLY OPERABLE LOUVERS c/w BIRD SCREENS
- 1 - 16" VENTURI XP. WALL MOUNTED EXHAUST FAN 115/230v, 1ph, 60hz, 1/4hp (36 ACPH) CLASS 1, DIV 1, GROUP C&D c/w BACKDRAFTDAMPER & WEATHER HOOD(TO BE INSTALLED)
- 2 - DOUBLE DOOR CANOPIES (SHIP LOOSE)
- CLIMASEAL FASTENERS THROUGHOUT
- P.ENG. STAMPED BUILDING DWGS. REQ'D. (ALBERTA REGISTERED)

- DESIGN LOADS: SLAVE LAKE AREA
- 1/50 SNOW = 1.9kPa
- 1/50 WIND = 0.37kPa


- APX. OVERALL BLDG. DIMENSIONS:
- WIDTH = 201"
- HEIGHT = 181" PLUS SKID

- NOTE:
- ALL DIMENSIONS ARE IN INCHES AND DECIMAL INCHES.
 - DO NOT SCALE DRAWINGS.
 - ALL DIMENSIONS TO WINDOWS AND DOORS ARE TO ROUGH OPENINGS.
 - CONFIRM LOCATION OF ANY LOUVERS AND OR FANS PRIOR TO INSTALLATION
 - CENTER BUILDING ON SKID
 - BUILDING INSTALLATION & ASSEMBLY SHALL BE AS PER WARWICK INSTALLATION MANUAL, AND DETAILS. WHERE THERE ARE CONFLICTS INFORMATION ON DRAWINGS SHALL BE TAKEN AS CORRECT

LEGEND	
DS = DOUBLE GLAZED	CC = CHECK CHAIN
IWG = INDUSTRIAL WIRE GLASS	WS = WEATHERSTRIPPING
RH = RIGHT HAND SWING	DC = HYDRAULIC CLOSURE
LH = LEFT HAND SWING	SG = INTERIOR SLIDE GATE
PH = PANIC HARDWARE	GA = GAUGE
LS = LOCK CYLINDER	INS = INSULATED
R-12 = CORE INSULATION (R-12)	

NOTES:

BUILDING IS DESIGNED TO COMPLY WITH N.B.C. 2005 AS PER THE WIND AND SNOW LOAD SPECIFIED ON THE DRAWING. OWNER SHALL CONTACT WARWICK INDUSTRIES, IF ACTUAL BUILDING LOCATION DIFFERS FROM THOSE SHOWN, IN ORDER TO VALIDATE THE STABILITY OF THE DESIGN FOR THE INTENDED LOCATION.

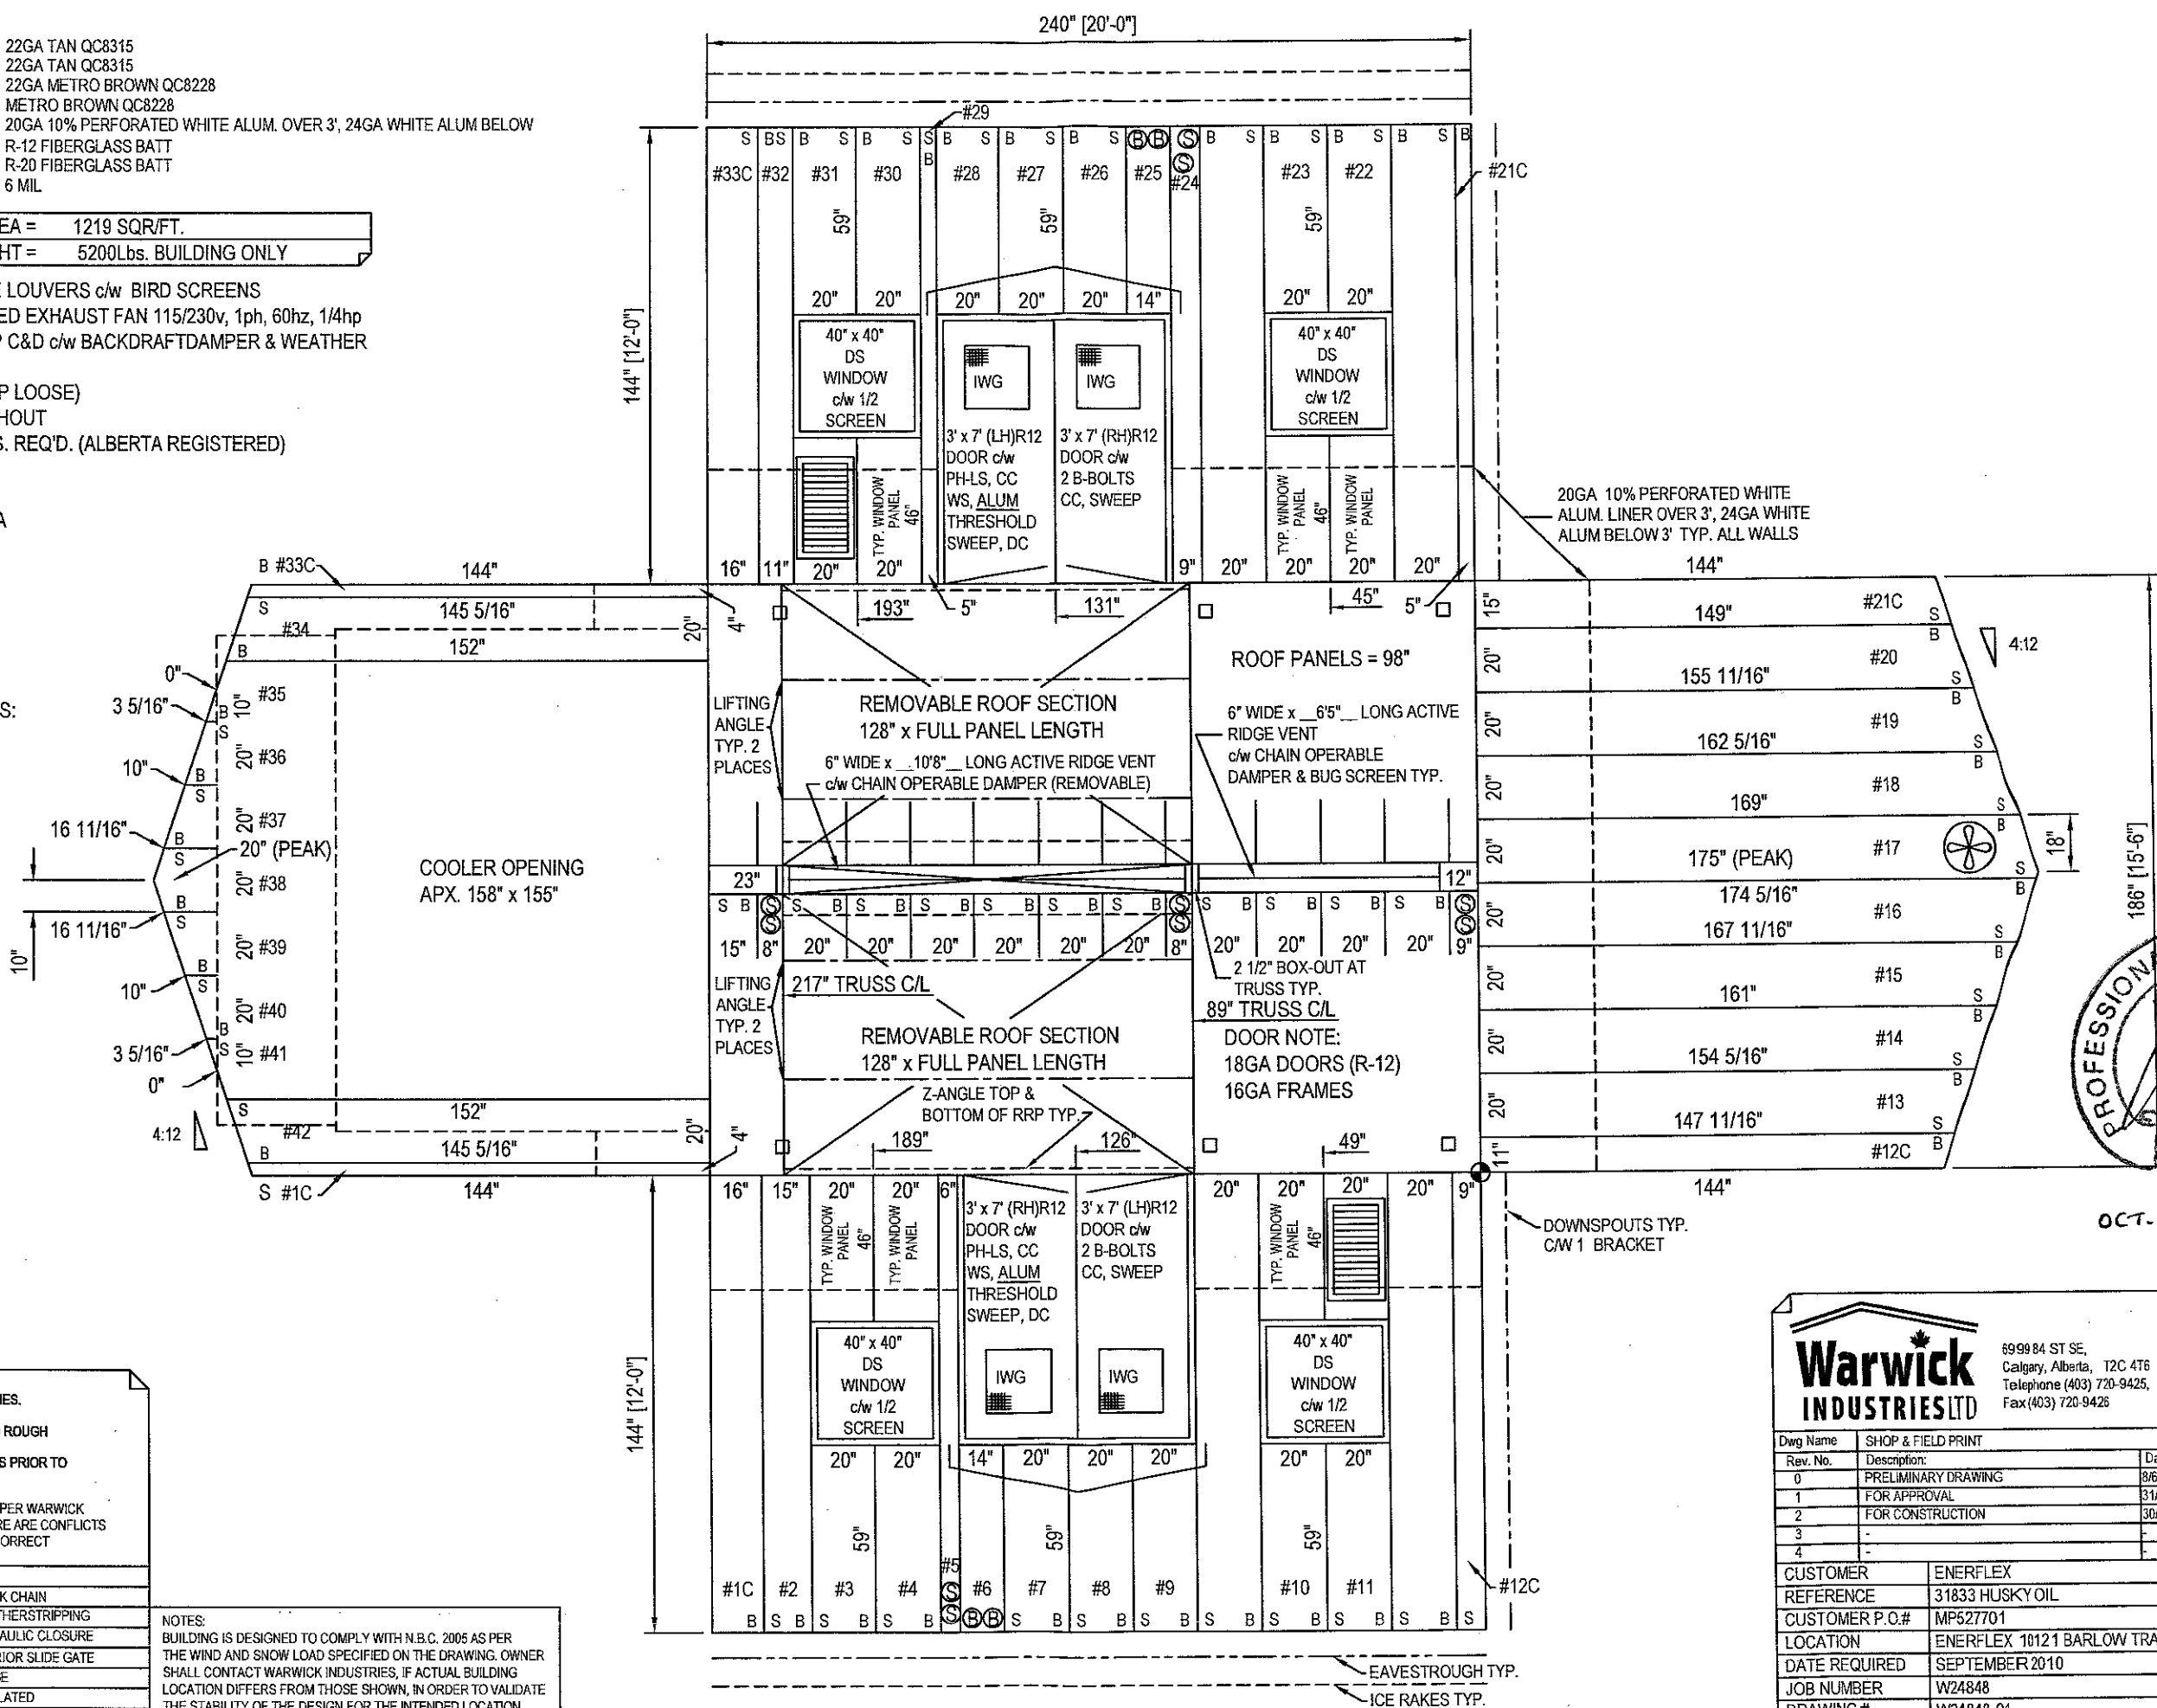

Warwick
INDUSTRIES LTD

6999 84 ST SE,
Calgary, Alberta, T2C 4T6
Telephone (403) 720-9425,
Fax (403) 720-9426

Dwg Name		SHOP & FIELD PRINT		
Rev. No.	Description:	Date:	Drawn By:	Checked By:
0	PRELIMINARY DRAWING	8/6/2010	AD	AD
1	FOR APPROVAL	31/8/2010	AD	AD
2	FOR CONSTRUCTION	30/9/2010	AD	
3	-	-	-	
4	-	-	-	
CUSTOMER		ENERFLEX		
REFERENCE		31833 HUSKY OIL		
CUSTOMER P.O.#		MP527701		
LOCATION		ENERFLEX 10121 BARLOW TRAIL N.E.		
DATE REQUIRED		SEPTEMBER 2010		
JOB NUMBER		W24848		
DRAWING #		W24848-01		

