
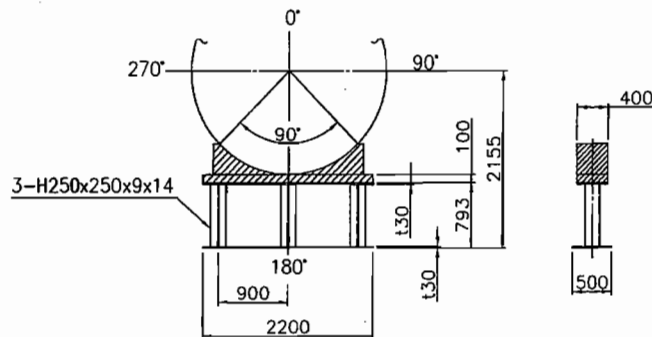


Project : VOYAGEUR HYDROTREATERS PROJECT

Client : SUNCOR ENERGY INC.

SEWON Job No. : D-0591

<u>Item No.</u> 207C-309		<u>Packing Style</u> Wooden & Steel Skid		<u>Drawing No.</u> D0591-207C309-D-01		<u>Description</u> RECYCLE GAS COMPRESSOR KNOCK OUT DRUM
<u>Q'TY</u> 1	<u>Net Weight</u> 42460 kg	<u>Gross Weight</u> 43570 kg	<u>Measurement</u> 91.759 M <sup>3</sup>		<u>Dimension</u> 8100L x 3070W x 3690H	<u>Remarks</u> Tailing Lug : 0° Lifting Trunnions : 90°, 270°

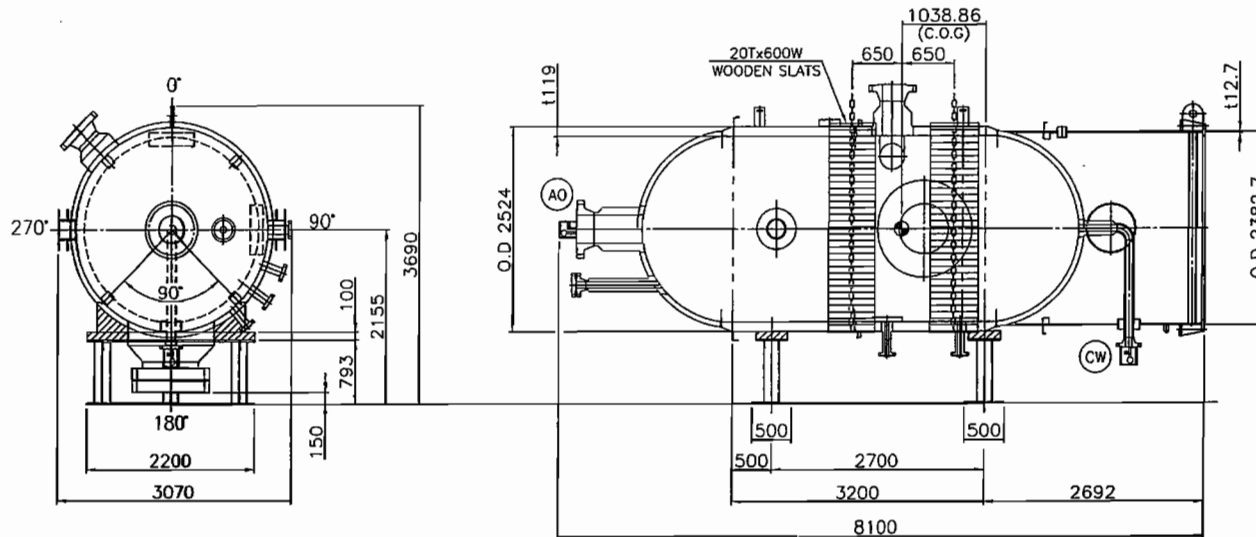

DETAIL OF SAID

AS-BUILT

ASME-U



FOR APPROVAL

REFERENCE DRAWINGS

1. GENERAL ASSEMBLY

D0591-207C309-D-01

REV	DATE	DESCRIPTION	BY	CHKD	REV'D	APP'D
0001	04/08	AS-BUILT	S.E.A	04/08/08	X	X
0002	02/19	FOR APPROVAL	S.E.A	02/19/08	X	X
0003	11/04	FOR APPROVAL	S.E.A	11/04/08	X	X
0004	06/10	1 <sup>ST</sup> ISSUE & FOR APPROVAL	S.E.A	06/10/08	X	X
DESCRIPTIONS FOR REVISION						
REV	DATE	DESCRIPTIONS FOR REVISION	BY	CHKD	REV'D	APP'D
PROJECT						
VOYAGEUR HYDROTREATERS PROJECT						
ENGINEER COLT ENGINEERING CORPORATION						
PO# 5919-M307						
CLIENT SUNCOR ENERGY INC.						
TITLE						
207C-309 RECYCLE GAS COMPRESSOR KNOCK OUT DRUM						
DETAIL OF TRANSPORTATION SKETCH						
SEWON CELLONTECH CO., LTD. CHANGWON, KOREA						
PROJECT NO.	D0591-002	SEWON JOB NO.	D-0591	POWERS	C	
SCALE	SEE DWG.	PROJECT NO.	06-C-5919	SEWON DWG. NO.	D0591-207C309-D-12	REV.